


Map No. _____ Sec. 14 Twp. 25 R. 13⁸Well No. 1 Wilson Farm _____

Company _____

NORTH

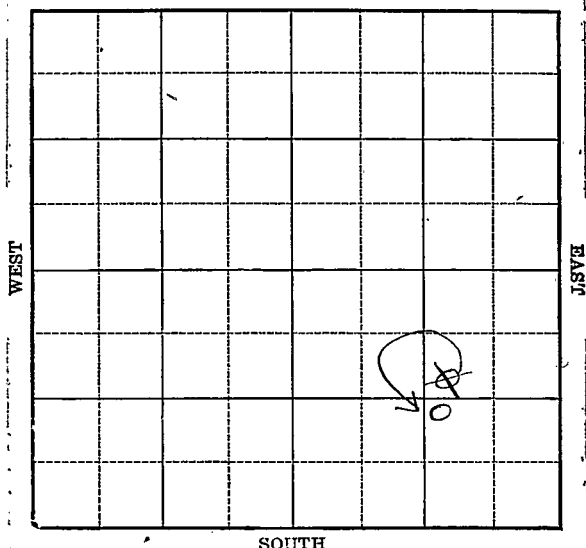

SOUTH

Location _____

Drilling Remarks _____

Rig Up _____

Drilling Remarks _____

RECORD

Cased _____ in. _____ ft.

Sand _____

Gas _____

Oil _____

Total Depth _____

PRODUCTION

1st 24 hrs. Nat. _____

1st 24 hrs. after shot _____

Gas _____ cu. ft.

Dry Hole _____

Abandoned _____

Woodson

Map No. KANSAS Sec. 14 Twp. 25 R. 13 E

Well No. 1 Wilson Farm


Perry Cannon Company

1070 Ft. from N. Line

1070 Ft. from S. Line

1070 Ft. from E. Line

_____ Ft. from W. Line

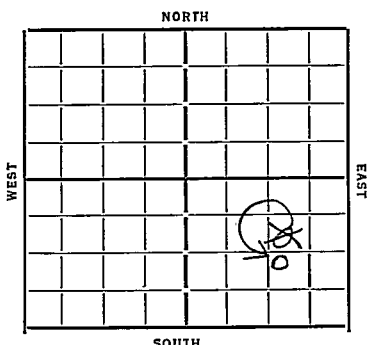

Date 12/33

REPORT

12/20 To R

12/27 —

1/4 Drill 200

1/11 " 340

1/17 " 800 8" at 307

1/24 " 1007

1/31 " 1405

2/7 TD 1470 50

2/14 Sand 1435 TD 1495 shot
80 gte CO

2/23 —

2/28 Sand 1435-95 YD shot 80
gte 40 Bbl. N. 5'

COMPLETED

Map No. 17 Sec. 14 Twp. 25 R. 13E

Well No. 1-Wilson

Perry Cannon Company

Contractor

FIRST REPORTS

SECTION PLAT

1070 Ft. from N. Line

..... Ft. from S. Line

1070 Ft. from E. Line

..... Ft. from W. Line

			0

Location ☒

Rig up.....

Drilling and Remarks:

RECORD

Cased.....in.,ft.

Sand.....

Gas.....

Oil.....

Total Depth.....

PRODUCTION

1st 24 hrs. Nat.....

1st 24 hrs. after shot.....

Gas.....Cu. Ft.

Dry Hole.....

Abandoned.....

Date

12-20-33 192 O. Mannscheck Scout

Map No. 17 Sec. 14 Twp. 25 R. 13EWell No. 1- WilsonPerry Cannon Company

Contractor

SECTION PLAT

CORRECTION

Ft. from N. Line

1070 Ft. from S. Line1070 Ft. from E. Line

Ft. from W. Line

			0
			0
			0
			0

CORRECTION

Location

Rig up

Drilling and Remarks:

RECORD

Cased.....in.,ft.

Sand.....

Gas.....

Oil.....

Total Depth.....

PRODUCTION

1st 24 hrs. Nat.....

1st 24 hrs. after shot.....

Gas.....Cu. Ft.

Dry Hole.....

Abandoned.....

Date

1-3-34 192 O. Mannheim ScoutChange to
above location

Map No. 17 Sec. 14 Twp. 25 R. 13EWell No. 1- WilsonPerry Cannon Company

Contractor

SECTION PLAT

Ft. from N. Line

1070 Ft. from S. Line1070 Ft. from E. Line

Ft. from W. Line

COMPLETED

			0

Location

Rig up

Drilling and Remarks:

50 fts40 bbls

RECORD

Cased in, ft.Sand 1435-95

Gas

Oil

Total Depth 1495

PRODUCTION

1st 24 hrs. Nat.

1st 24 hrs. after shot

Gas Cu. Ft.

Dry Hole

Abandoned

Date

2-28-34 C. W. Mansbach 192 Scout