

4-9-2005

STATE CORPORATION COMMISSION OF KANSAS
OIL & GAS CONSERVATION DIVISION
WELL COMPLETION OR RECOMPLETION FORM
ACO-1 WELL HISTORY
DESCRIPTION OF WELL AND LEASE

API No. 15-087-20397
County Jefferson
NE NE SE 4 9 20 X East
..... Sec..... Twp..... Rge..... West

Operator: License # 3429
Name Razorback Exploration, Inc.
Address P.O. Box 3135
Borger, Texas
City/State/Zip 79008

2310
330
..... Ft North from Southeast Corner of Section
..... Ft West from Southeast Corner of Section
(Note: Locate well in section plat below)

Purchaser N/A

Lease Name Jones Well # 1-87-4

Operator Contact Person Timothy J. Justice
Phone 913-841-6377

Field Name Unknown

Contractor: License # 5786
Name McGown Drilling

Producing Formation Dry Hole

Wellsite Geologist George Peterson
Phone 913-272-4838

Elevation: Ground 1032 KB

Designate Type of Completion

XX New Well Re-Entry Workover


Oil SWD Temp Abd
Gas Inj Delayed Comp.
XX Dry Other (Core, Water Supply etc.)

If ONWO: old well info as follows:

Operator
Well Name
Comp. Date Old Total Depth

KANSAS GEOLOGICAL SURVEY
WICHITA BRANCH

Section Plat

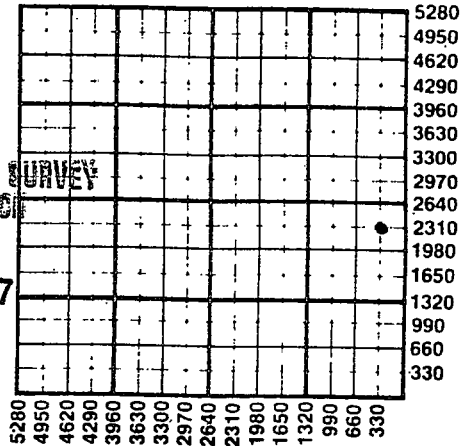

DEC 29 1987

WATER SUPPLY INFORMATION

Disposition of Produced Water: Disposal
Docket # N/A Repressuring

WELL HISTORY

Drilling Method: X Mud Rotary Air Rotary Cable
12-10-87 12-12-87 P & A
Spud Date Date Reached TD Completion Date

1510 N/A
Total Depth PBTD

Amount of Surface Pipe Set and Cemented at.....feet
Multiple Stage Cementing Collar Used? Yes X No
If yes, show depth set.....feet
If alternate 2 completion, cement circulated
from Surf. feet depth to 40 w/ 90 SX cmt
Cement Company Name Halliburton Services
Invoice #

Questions on this portion of the ACO-1 call:
Water Resources Board (913) 296-3717

Source of Water:
Division of Water Resources Permit #

Groundwater.....Ft North from Southeast Corner
(Well)Ft West from Southeast Corner of
Sec Twp Rge East West

Surface Water.....Ft North from Southeast Corner
(Stream, pond etc).....Ft West from Southeast Corner
Sec Twp Rge East West

X Landowner Pond
Other (explain).....
(purchased from city, R.W.D. #)

INSTRUCTIONS: This form shall be completed in triplicate and filed with the Kansas Corporation Commission, 200 Colorado Derby Building, Wichita, Kansas 67202, within 120 days of the spud date of any well. Rule 82-3-130, 82-3-107 and 82-3-106 apply.

Information on side two of this form will be held confidential for a period of 12 months if requested in writing and submitted with the form. See rule 82-3-107 for confidentiality in excess of 12 months. One copy of all wireline logs and drillers, time log shall be attached with this form. Submit CP-4 form with all plugged wells. Submit CP-111 form with all temporarily abandoned wells.

STATE OF KANSAS
OIL & GAS CONSERVATION DIVISION
Wichita, Kansas

Operator Name **RAZORBACK EXPLORATION, INC.** Lease Name **JONES** Well # **1-87-4**

Sec. **4** Twp. **9 S** Rge. **20** East West County **Jefferson**

WELL LOG

INSTRUCTIONS: Show important tops and base of formations penetrated. Detail all cores. Report all drill stem tests giving interval tested, time tool open and closed, flowing and shut-in pressures, whether shut-in pressure reached static level, hydrostatic pressures, bottom hole temperature, fluid recovery, and flow rates if gas to surface during test. Attach extra sheet if more space is needed. Attach copy of log.

Drill Stem Tests Taken Yes No
 Samples Sent to Geological Survey Yes No
 Cores Taken Yes No

Formation Description

Log Sample

Name Top Bottom

See Attached Logs

CASING RECORD <input type="checkbox"/> New <input type="checkbox"/> Used							
Report all strings set-conductor, surface, intermediate, production, etc.							
Purpose of String	Size Hole Drilled	Size Casing Set (in O.D.)	Weight Lbs/Ft.	Setting Depth	Type of Cement	#Sacks Used	Type and Percent Additives
Surface	12 1/4	8 5/8	23	40	50/50 paz	90	Gilsonite 3%
PERFORATION RECORD				Acid, Fracture, Shot, Cement Squeeze Record			
Shots Per Foot	Specify Footage of Each Interval Perforated			(Amount and Kind of Material Used)		Depth	
	N/A			N/A			
TUBING RECORD				Liner Run	<input type="checkbox"/> Yes <input type="checkbox"/> No		
Date of First Production	Producing Method						
P & A	<input type="checkbox"/> Flowing <input type="checkbox"/> Pumping <input type="checkbox"/> Gas Lift <input type="checkbox"/> Other (explain).....						