

Map No. Kansas Sec. 14 Twp. 25 R. 13


Well No. 2 Wilson Farm
Lassen et al Company

_____ Ft. from N. Line

250 Ft. from S. Line

660 Ft. from E. Line

_____ Ft. from W. Line

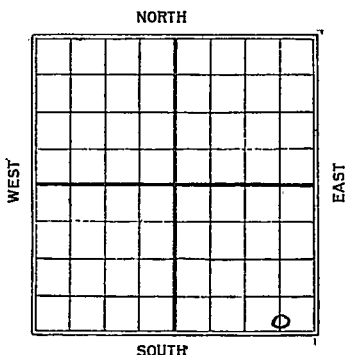

C.

Date	REPORT
1925	
5/8	Rigging up
5/29	_____
6/5	S.D. 875
6/12	_____
6/19	_____
6/20	_____
7/3	_____
7/10	_____
7/17	_____
7/24	Build sand, 1401-08
	T.D. 1435 water
	L.O. + d.

Map No. 1424 Sec. 14 Twp. 25 R. 13

Well No. 2 Wilson
Hessen et al Company

Contractor

SECTION PLAT

			0

_____ Ft. from N. Line

250 Ft. from S. Line

660 Ft. from E. Line

_____ Ft. from W. Line

FIRST REPORTS

Location _____

Rig up _____

Drilling and Remarks:

(machine)
rigging up.

RECORD

Cased _____ in., _____ ft.

Sand _____

Gas _____

Oil _____

Total Depth _____

PRODUCTION

1st 24 hrs. Nat. _____

1st 24 hrs. after shot _____

Gas _____ Cu. Ft.

Dry Hole _____

Abandoned _____

Date

MAY 8 1925

192

CHAS. L. SHERWOOD

Scout

Map No. 14 Sec. 14 Twp. 25 R. 13

Well No. 2 WILSON

LASSEN of AK Company

Contractor

ABANDONED

SECTION PLAT

_____ Ft. from N. Line

250 Ft. from S. Line

660 Ft. from E. Line

_____ Ft. from W. Line

			6

Completed

Location _____

Rig up _____

Drilling and Remarks:

Bo AD 1401-08
Small show oil
dry & abandoned

AD 1435 1401-08

RECORD

Cased _____ in., _____ ft.

Sand _____

Gas _____

Oil _____

Total Depth 1435'

PRODUCTION

1st 24 hrs. Nat. _____

1st 24 hrs. after shot _____

Gas _____ Cu. Ft.

Dry Hole

Abandoned

Date

JUL 24 1955

CHAS. L. SHERWOOD