

Sec. 14 Twp. 16 R. 12-W

Well No. #2 Feltes Farm

R. E. Day et al Company

(Beaver)


_____ Ft. from N. Line

990 Ft. from S. Line

660 Ft. from E. Line

_____ Ft. from W. Line

Elev. 1905

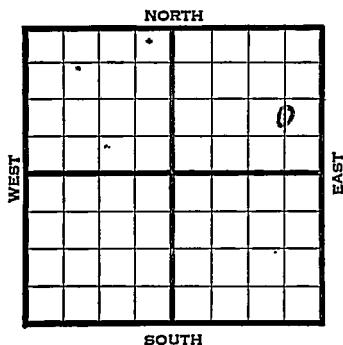

1941	REPORT
1/8	Location
1/16	"
1/23	Cable rig.
1/30	Rigging up.
2/6	12" - 265' Drlg. 520'
2/13	10" - 515' Anhy 781-88' T.D. U.R. 10".
2/20	10" - 749' Drlg. 1316'
2/27	8" - 2130' Drlg. 2215'
3/6	8" - 2516' Drlg. 2535'
3/13	Lans. 3065' S.O. 3008-15' T.D. 3105' Run 7".
3/20	7" - 3152' Drlg. 3255'
3/27	Arb. 3332 3332' 5" - 3332' T.D. 3342' 3200' oil 3 hours. 1500 acid.
	OVER

1941

4/2

Arb. 3332'

5" - 3332'

T.D. 3342'

1500 acid.

Depthograph potential 756,000

Maximum 3000 bbls.

40. Gravity

COMPLETED

Map No. 55 Sec. 14 Twp. 16 R. 12W

Well No. 2 Feltes

R. E. Day et al

Company

Contractor

FIRST REPORT

SECTION PLAT

C N L SE NE

_____ Ft. from N. Line

990 Ft. from S. Line

660 Ft. from E. Line

_____ Ft. from W. Line

			o

BEAVER POOL

Location X

Rig up _____

Drilling and Remarks:

RECORD

Cased _____ in., _____ ft.

Sand _____

Gas _____

Oil _____

Total Depth _____

PRODUCTION

1st 24 hrs. Nat. _____

1st 24 hrs. after shot _____

Gas _____ Cu. Ft.

Dry Hole _____

Abandoned _____

Date

JAN 8 1941

19

S. J. LEWIS Scout

Map No. 55 Sec. 14 Twp. 16 R. 12W

Well No. 2 Feltes

R. E. Day etal Company

Contractor

COMPLETED

SECTION PLAT

C N L SE NE

_____ Ft. from N. Line

990 Ft. from S. Line

660 Ft. from E. Line

_____ Ft. from W. Line

BEAVER POOL

			o

Location _____

Rig up _____

Drilling and Remarks:

Cor 83332

51103332

1500 actual

Dept. No. 756000

Map 3000

40 1/2

RECORD

Cased _____ in., _____ ft.

Sand _____

Gas _____

Oil _____

Total Depth 3342

PRODUCTION

1st 24 hrs. ~~Nat.~~ _____

1st 24 hrs. after shot _____

Gas _____ Cu. Ft.

Dry Hole _____

Abandoned _____

Date

APR 2 1941 19

S. J. LEWIS Scout