


Section 14 Township 16 Range 12W

Well No. #6 Feltes

Company R. E. Day

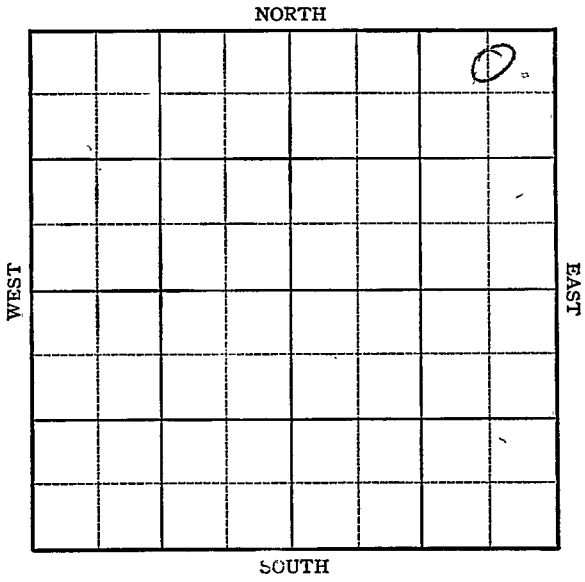

KANSAS

Barton County

Sec. 14 Twp. 16 R. 12W

Well No. #6 Feltes Farm

R. E. Day Company


Kraft-Prusa

330 Ft. from N. Line

_____ Ft. from S. Line

660 Ft. from E. Line

_____ Ft. from W. Line

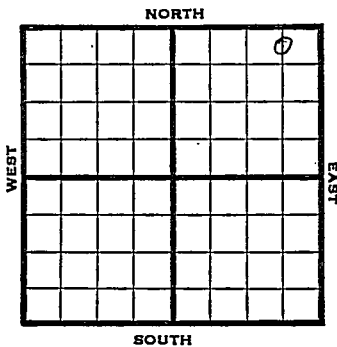

CNL NE NE

1946

Elev. 1963

REPORT

2/6 Anhy. 778
8" @ 787' WOC

2/14 Drlg. 2740'

2/21 T.D. 3367'

2/27 Lans. 3081
Arb. 3363
TD 3395'

ABANDONED

KANSAS

Kansas Pool Name Kraft-Prusa

Map No. 55 Sec. 14 Twp. 16 R. 12W

Well No. 6 Feltes

R. E. Day Company

FIRST REPORT Contractor
C N L NE NE

SECTION PLAT

330 Ft. from N. Line

 Ft. from S. Line

660 Ft. from E. Line

 Ft. from W. Line

			0

Barton County

Location _____

Rig up _____

Drilling and Remarks:

anhy 778
8"-787 WOC

RECORD

Cased _____ in., _____ ft.

Sand _____

Gas _____

Oil _____

Total Depth _____

PRODUCTION

1st 24 hrs. Nat. _____

1st 24 hrs. after shot _____

Gas _____ Cu. Ft.

Dry Hole _____

Abandoned _____

Date

FEB 6 1946 19

S. J. LEWIS

Scout

Kansas Pool Name Kraft-PrusaMap No. 55 Sec. 14 Twp. 16 R. 12WWell No. 6 FeltesR. E. Day Company**ABANDONED**

Contractor

C N L NE NEE 11963
SECTION PLAT330 Ft. from N. Line Ft. from S. Line .660 Ft. from E. Line Ft. from W. Line

			6

Barton County

Location Rig up

Drilling and Remarks:

Lease 3087Ord 3363**RECORD**Cased in., ft.Sand Gas Oil Total Depth 3375**PRODUCTION**1st 24 hrs. Nat. 1st 24 hrs. after shot Gas Cu. Ft.Dry Hole Abandoned

Date

FEB 27 194619S. J. LEWIS

Scout