


Map No. _____ Sec. 15 Twp. 25 R. 13

Well No. 1-Brown Farm _____
Chas. Cross Company _____

250 Ft. from N. Line
 _____ Ft. from S. Line
250 Ft. from E. Line
 _____ Ft. from W. Line

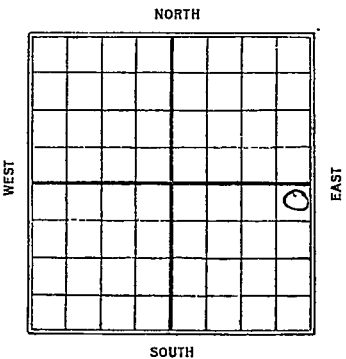

1927

Date	REPORT
<u>9/14</u>	<u>Location</u>
<u>9/29</u>	_____
<u>10/6</u>	<u>machine</u>
<u>10/12</u>	_____
<u>10/19</u>	<u>Spudding</u>
<u>10/27</u>	<u>Drilg 650'</u>
<u>11/2</u>	<u>" 1100'</u>
<u>11/9</u>	<u>Sdy Shale 1472-1547-dry</u> <u>drilling-</u>
<u>11/16</u>	<u>Sdy shale 1472-1570</u>
	<u>top line 1609</u>
	<u>break 1652-1657</u>
	<u>D. & A. 1657</u>

normal
KANSAS
Map No. *15* Sec. *15* Twp. *25* R. *13*
Well No. *1* *Brown*
Chs Cross

Company

Contractor

FIRST REPORTS

SECTION PLAT

250 Ft. from N. Line
Ft. from S. Line
250 Ft. from E. Line
Ft. from W. Line

			0

Location

Rig up

Drilling and Remarks:

RECORD

Cased _____ in., _____ ft.
Sand _____
Gas _____
Oil _____
Total Depth _____

PRODUCTION

1st 24 hrs. Nat. _____
1st 24 hrs. after shot _____
Gas _____ Cu. Ft.
Dry Hole _____
Abandoned _____

Date

SEP 14 1927

1927

CHAS. L. SHERWOOD
Scout

no map
Map No. **KANSAS** Sec. **15** Twp. **25** R. **13**
Well No. **Blown**
Chas Cross

Company

Contractor

COMPLETED

250 Ft. from N. Line

_____ Ft. from S. Line

250 Ft. from E. Line

_____ Ft. from W. Line

ABANDONED

SECTION PLAT

			o

Location _____

Rig up _____

Drilling and Remarks:

Sdy shale 1472-1570
Top line 1609
Blow 1652-1657

RECORD

Cased _____ in., _____ ft.

Sand _____

Gas _____

Oil _____

Total Depth **1657**

PRODUCTION

1st 24 hrs. Nat. _____

1st 24 hrs. after shot _____

Gas _____ Cu. Ft.

Dry Hole

Abandoned

Date

NOV 16 1927

CHAS. L. SHERWOOD

Scout