



*Greenwood*

Map No. KANSAS Sec. 15 Twp. 25 R. 13<sup>E</sup>

Well No. 1 Kolb Farm


Wolf Creek Company

\_\_\_\_\_ Ft. from N. Line

330 Ft. from S. Line

271 Ft. from E. Line

\_\_\_\_\_ Ft. from W. Line

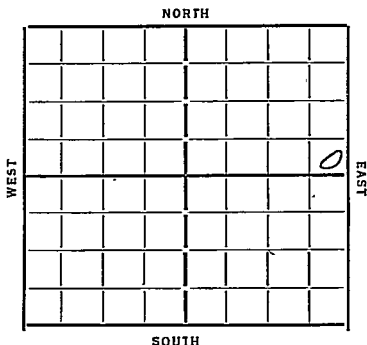

Date REPORT

7/5 *Machine*

7/12 *—*

7/19 *spud*

7/26 *dig 650'*

8/2 *" 850'*

8/9 *" 1300'*

8/17 *6" 1484 sand - 1500' - 37 - 120 qt shot  
Est 100 bbls*

8/23 *T.D. 1534 sand correction 1495 - 1531  
flow 60 bbls 6 hrs*

8/30 *Sand 1500 - 37  
T. D. 1537  
Est 100 bbls*

COMPLETED

**KANSAS**

Map No. \_\_\_\_\_ Sec. 15 Twp. 25 R. 13E

Well No. 1 - Kolb

Wolf-Creek Company

Contractor \_\_\_\_\_

**SECTION PLAT**

\_\_\_\_\_ Ft. from N. Line

330 Ft. from S. Line

271 Ft. from E. Line

\_\_\_\_\_ Ft. from W. Line

			o

**FIRST REPORTS**

Location \_\_\_\_\_

Rig up \_\_\_\_\_

Drilling and Remarks:

Machine

**RECORD**

Cased \_\_\_\_\_ in., \_\_\_\_\_ ft.

Sand \_\_\_\_\_

Gas \_\_\_\_\_

Oil \_\_\_\_\_

Total Depth \_\_\_\_\_

**PRODUCTION**

1st 24 hrs. Nat. \_\_\_\_\_

1st 24 hrs. after shot \_\_\_\_\_

Gas \_\_\_\_\_ Cu. Ft.

Dry Hole \_\_\_\_\_

Abandoned \_\_\_\_\_

Date \_\_\_\_\_

7/5/33 192 Orval Mammel

✓

*Brownwood*

Map No. *17* Sec. *15* Twp. *25* R. *13E*

Well No. *1 - Kalb*

*Walpi Creek* Company

Contractor

SECTION PLAT

			0

..... Ft. from N. Line

*330* Ft. from S. Line

*271* Ft. from E. Line

..... Ft. from W. Line

**COMPLETED**

Location.....

Rig up.....

Drilling and Remarks:

*Est 100 bbls*

RECORD

Cased..... in., ..... ft.

Sand *1500 - 37*

Gas.....

Oil.....

Total Depth *1537*

PRODUCTION

1st 24 hrs. Nat.....

1st 24 hrs. after shot.....

Gas..... Cu. Ft.

Dry Hole.....

Abandoned.....

Date

*8/30/33* 192 *O. Mansel*