


Barton

FORM 51 5M 1-42 PETROL

Section 14 Township 16 Range 12-W

Well No. #1 Theisen

Company Phillips Pet.

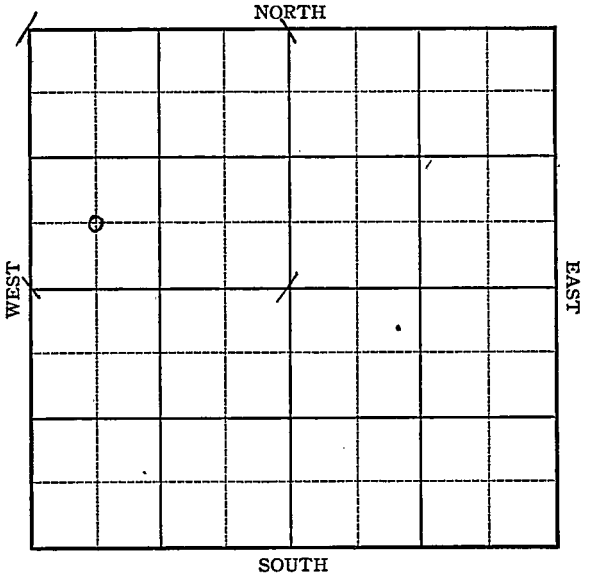

Sec. 14 Twp. 16 R. 12-W

Well No. #1 Theisen Farm

Phillips Pet. Company

Beaver


_____ Ft. from N. Line

660 Ft. from S. Line

_____ Ft. from E. Line

660 Ft. from W. Line

Elev. 1921

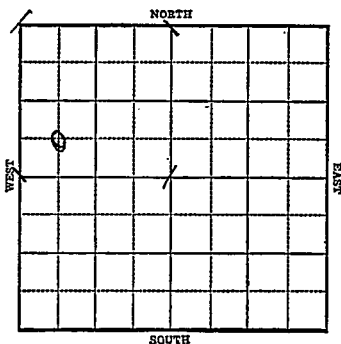

1943

R E P O R T

- 4/21 Shut down for repairs 513'
- 4/28 8" @ 498'
Anhy 784
Drlg. 2985'
- 5/5 Topeka 2705
Lans 3117
Arb 3380
T.D. 3386
5" @ 3380 RUST.
- 5/12 Bail $\frac{1}{2}$ oil $1\frac{1}{2}$ water PH-12 hrs.
- 5/19 Arb. 3380
5" - 3380
500 acid
Water
T.D. 3386

ABANDONED

Map No. KANSAS Sec. 14 Twp. 16 R. 12W

Well No. 1 Theisen

Phillips Petroleum Company

FIRST REPORT Contractor

C SW NW

_____ Ft. from N. Line

660 Ft. from S. Line

_____ Ft. from E. Line

660 Ft. from W. Line

SECTION PLAT

D			

BEAVER POOL

Location _____

Rig up _____

Drilling and Remarks:

Shut D own for
Repairs 513'

RECORD

Cased _____ in., _____ ft.

Sand _____

Gas _____

Oil _____

Total Depth _____

PRODUCTION

1st 24 hrs. Nat. _____

1st 24 hrs. after shot _____

Gas _____ Cu. Ft.

Dry Hole _____

Abandoned _____

Date

APR 21 1943 19

S. J. LEWIS Scout

KANSAS

Barton

Map No. 55 Sec. 14 Twp. 16 R. 12W

Well No. 1 Theisen

Phillips Petroleum Company

ABANDONED

Contractor

C S W NW

SECTION PLAT

o			

_____ Ft. from N. Line

660 Ft. from S. Line

_____ Ft. from E. Line

660 Ft. from W. Line

BEAVER POOL

Location _____

Rig up _____

Drilling and Remarks:

Core 3380
5" @ 3380
500 acid
Water

RECORD

Cased _____ in., _____ ft.

Sand _____

Gas _____

Oil _____

Total Depth 3386

PRODUCTION

1st 24 hrs. Nat. _____

1st 24 hrs. after shot _____

Gas _____ Cu. Ft.

Dry Hole _____

Abandoned _____

Date

MAY 19 1943

19

S. J. LEWIS Scout