


Section 14 Township 16 Range 12W

Well No. 2 M. Oser

Company Stanolind

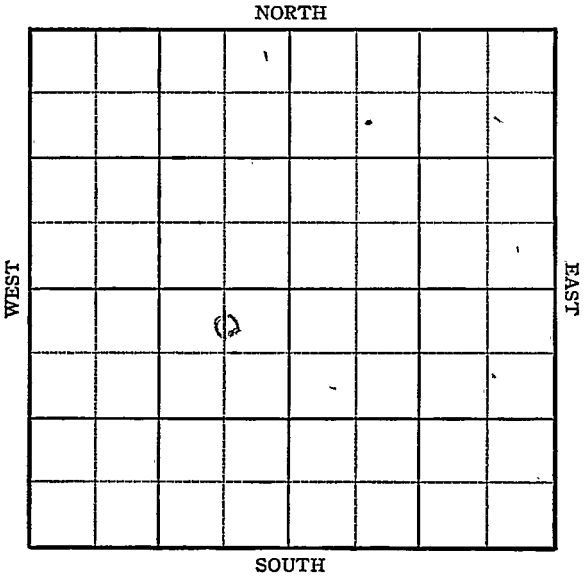

Sec. 14 Twp. 16 R. 12-W

Well No. #2 M. Oser Farm _____


Stanolind Company _____

330 Ft. from N. Line

_____ Ft. from S. Line

660 Ft. from E. Line

_____ Ft. from W. Line

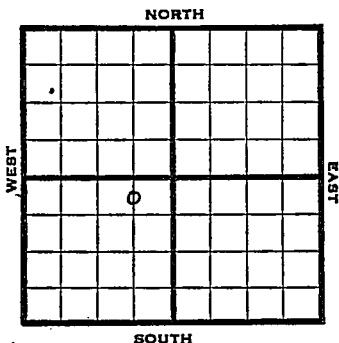

C N L NE SW Elev. 1914

1945

REPORT

9/5 Location

9/12 Derrick

9/19 RUR

9/26 Surface-hole

10/3 13" @ 156

Anhy. 800

Drlg. 1930

10/10 Drlg. 3138'

10/17 Lans 3095

Arb. 3251

TD 3258

5" @ 3257 RUST

10/24 " "

10/31 S-ab 10 oil per hr. 4 hrs.

11/7 Arb. 351

5" @ 3351

TD 3358

Pump 132 Pot.

Grav. 42.0

COMPLETED

KANSAS

Pool Name Kraft-Prusa

Map No. 95 Sec. 14 Twp. 16 R. 12W

Well No. 2 M. Oser

Stanolind _____ Company

FIRST REPORT

Contractor _____

C N L NE SW

SECTION PLAT

330 Ft. from N. Line

_____ Ft. from S. Line

660 Ft. from E. Line

_____ Ft. from W. Line

| | | | |
|--|---|--|--|
| | | | |
| | | | |
| | o | | |
| | | | |

Barton County

Location X

Rig up _____

Drilling and Remarks:

RECORD

Cased _____ in., _____ ft.

Sand _____

Gas _____

Oil _____

Total Depth _____

PRODUCTION.

1st 24 hrs. Nat. _____

1st 24 hrs. after shot _____

Gas _____ Cu. Ft.

Dry Hole _____

Abandoned _____

Date

SEP 5 1945 19

S. J. LEWIS Scout

KANSAS

Pool Name Kraft-Prusa.

Map No. 5-5 Sec. 14 Twp. 16 R. 12W

Well No. 2 M. Oser

Stanolind Company

COMPLETED

Contractor

C N L NE SW

E11914
SECTION PLAT

330 Ft. from N. Line

 Ft. from S. Line

660 Ft. from E. Line

 Ft. from W. Line

| | | | |
|--|---|--|--|
| | | | |
| | | | |
| | 6 | | |
| | | | |

Barton County

Location _____

Rig up _____

Drilling and Remarks:

Cr 3307

5' @ 3307

Pump 182.5 ft

42⁰ Gr

RECORD

Cased _____ in., _____ ft.

Sand _____

Gas _____

Oil _____

Total Depth 3307.

PRODUCTION

1st 24 hrs. Nat. _____

1st 24 hrs. after shot _____

Gas _____ Cu. Ft.

Dry Hole _____

Abandoned _____

Date

NOV 7 1945 19

S. J. LEWIS Scout