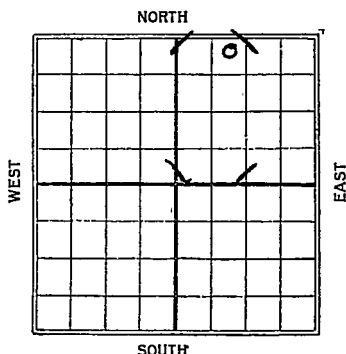


Map No. Kansas Sec. 23 Twp. 25 R. 13 ^EWell No. 1 Pasture Farm
Davis & Lassen Company200 Ft. from N. Line

_____ Ft. from S. Line

_____ Ft. from E. Line

1120 Ft. from W. Line1st & CompletedDate
1925

REPORT

4/10 Bkn. Sand 1378-88Pay 1388-98 T.D. 143180 gts 15 Bbls

Map No. KLn Bk Sec. 23 Twp. 25 R. 13^EWell No. 1 PHSKE
DAVIS & LASSEN Company

Contractor

FIRST REPORTS

COMPLETED

200 Ft. from N. Line

Ft. from S. Line

Ft. from E. Line

1120 Ft. from W. Line

SECTION PLAT

Location _____

Rig up _____

Drilling and Remarks:

Broken Ldn 13781388' Pay 1388-98TD 1431'shot 80 gts15 bls

RECORD

Cased _____ in., _____ ft.

Sand _____

Gas _____

Oil _____

Total Depth _____

PRODUCTION

1st 24 hrs. Nat. _____

1st 24 hrs. after shot _____

Gas _____ Cu. Ft.

Dry Hole _____

Abandoned _____

Date

APR 10 1925

192

Chas. L. Shewar Scout