

KANSAS


Woodson

Form 51-5M-4-36-Palace

Section 24 Township 25 Range 13-E

Well Number #2 Eades

Company Sheedy et al

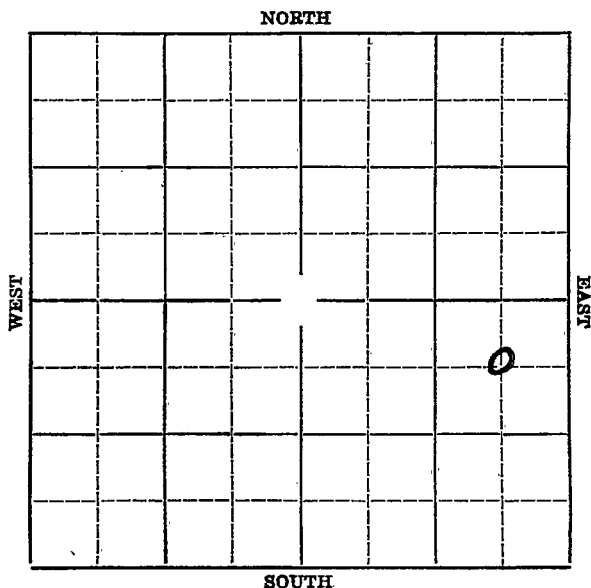

Map No. KANSAS Sec. 24 Twp. 25 R. 13E

Well No. #2 Eades Farm


Sheedy et al Company

660' Ft. from N. Line

 Ft. from S. Line

660' Ft. from E. Line

 Ft. from W. Line

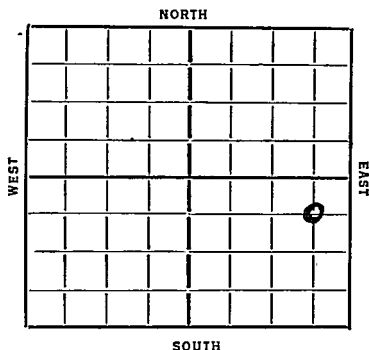

Date
1936

REPORT

7/15 Drlg. 660'.
7/23 Drlg. 750'.
7/30 Drlg. 1015'.
8/6 Drlg. 1370'.
8/13 Bart. sand 1447'. to 1477½'. TD
 1511'. Shot 70 qts. No test.
8/20 --
8/26/36 Bart. sand. 1447'.
 T.D. 1511'.
 Shot 70 qts.
 60 bbls of oil.

COMPLETED.

Map No. 17 Sec. 24 Twp. 25 R. 13E

Well No. 2 Eagles

Sheedy & Co. Company

Contractor

SECTION PLAT

			0

660 Ft. from N. Line

 Ft. from S. Line

660 Ft. from E. Line

 Ft. from W. Line

FIRST REPORT

Location

Rig up

Drilling and Remarks:

July 660

RECORD

Cased in., ft.

Sand

Gas

Oil

Total Depth

PRODUCTION

1st 24 hrs: Nat.

1st 24 hrs. after shot

Gas Cu. Ft.

Dry Hole

Abandoned

Date

JUL 15 1936

19

S. J. LEWIS

Scout

KANSAS

Map No. 17 Sec. 24 Twp. 25 R. 13EWell No. 2 EadesSheedy & Co. CompanySheedy & Co. Contractor

SECTION PLAT

			0

660 Ft. from N. Line Ft. from S. Line660 Ft. from E. Line Ft. from W. Line

COMPLETED

Location Rig up

Drilling and Remarks:

Bar & Sand1447Bar & 709 to60 ft

RECORD

Cased in., ft.Sand Gas Oil Total Depth 1511

PRODUCTION

1st 24 hrs. Nat. 1st 24 hrs. after shot Gas Cu. Ft.Dry Hole Abandoned

Date

AUG 26 193619S. J. LEWIS Scout