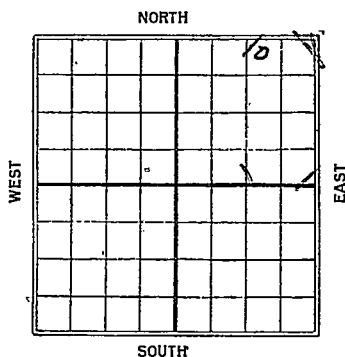


Map No. Kansas Sec. 23 Twp. 25 R. 13^EWell No. 1 Paste FarmMc Cann & Johnson Company200 Ft. from N. Line

_____ Ft. from S. Line

1120 Ft. from E. Line

_____ Ft. from W. Line

Date
1925

REPORT

4/10

1406-15 ~~F.D. 1424~~

50 Bbls Sho Will Shoot

5/8

1406-1418 30 Bbls not

Map No. *Kinds* Sec. *22* Twp. *25* R. *12^E*Well No. *1* *PASKE**McClure & Johnson* Company

Contractor

FIRST REPORTS

200 Ft. from N. Line

Ft. from S. Line

1120 Ft. from E. Line

Ft. from W. Line

SECTION PLAT

			<i>10</i>

Location

Rig up

Drilling and Remarks:

*Shut in 1406-1415**+ D 1424**50 bbl show.**will shoot*

RECORD

Cased _____ in., _____ ft.

Sand _____

Gas _____

Oil _____

Total Depth _____

PRODUCTION

1st 24 hrs. Nat. _____

1st 24 hrs. after shot _____

Gas _____ Cu. Ft.

Dry Hole _____

Abandoned _____

Date

APR 10 1925

192

Chas. L. Sherwood Scout

Map No. 11/4 N 45 W Sec. 23 Twp. 25 R. 13Well No. 1 45/10Mc Elroy & Johnson Company

Contractor

SECTION PLAT

200 Ft. from N. Line

Ft. from S. Line

1120 Ft. from E. Line

Ft. from W. Line

COMPLETED

			<u>10</u>

Location

Rig up

Drilling and Remarks:

RECORD

Cased 1406 in., 1418 ft.

Sand

Gas

Oil

Total Depth 1418

PRODUCTION

1st 24 hrs. Nat.

1st 24 hrs. after shot

Gas Cu. Ft.

Dry Hole

Abandoned

30 b/s natural

Date

MAY 8 1925

192

CHAS. L. SHERWOOD

Scout