

Gift of
 W. L. Stryker Esq's
 State Geological Survey of Kansas
 1970


C. E. WILSON FARM
 WELL NO. 1676

2-28-16E

Company: Okla Natural Gas Co.

SE $\frac{1}{4}$ of SW $\frac{1}{4}$ of
 Sec. 2-28-16,
 Wilson County, Kan

soil		5
lime	5	20
shale	20	35
shale	35	105
shale	105	120
lime	120	140
shale	195	
shale	233	
lime	243	
shale	260	
sand	300	
lime	308	
shale	345	
lime	386	
lime	420	
shale	423	
lime	430	
shale	435	
lime	475	
shale	480	
lime	527	
shale	575	
shale light	620	
lime	650	
shale	690	
shale brown	710	
sand	735	
shale	740	
lime	775	
shale	813	
lime	834	
shale	840	
lime	845	
shale	1070	
sand	1080	
oil sand	1110	
water sand	1115	

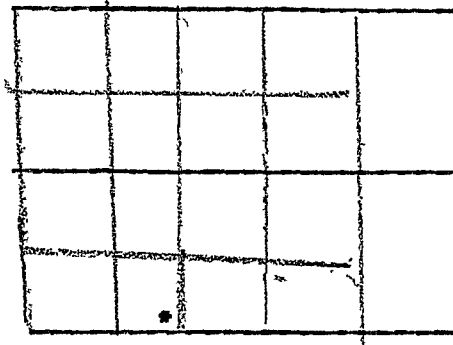

Casing record:

8	39	pulled out
6	532	" "
4-1/8	901	" "

Well Plugged Feb. 11th, 1929 by C. j. Studebaker.