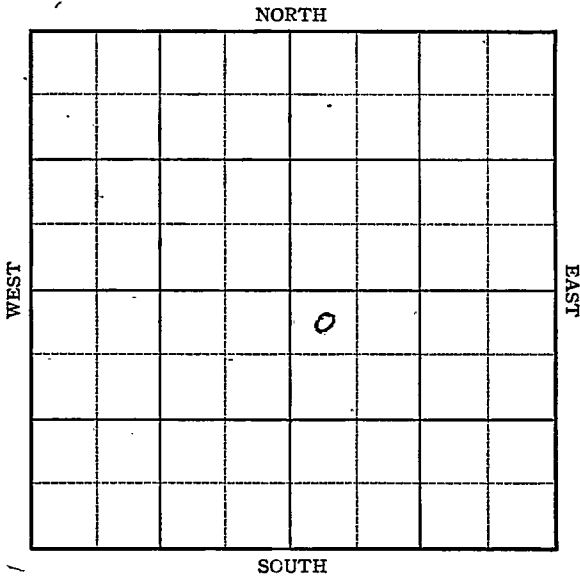


KANSAS

Barton

FORM 51 5M 11-44 PETROL

Section 10 Township 16 Range 12-WWell No. #2 ChristiansCompany Black-Marshall

KANSAS

Barton ✓

Sec. 10 Twp. 16 R. 12W

Well No. #2 Christians Farm

Black-Marshall Company


Kraft-Prusa

330 Ft. from N. Line

_____ Ft. from S. Line

_____ Ft. from E. Line

330 Ft. from W. Line

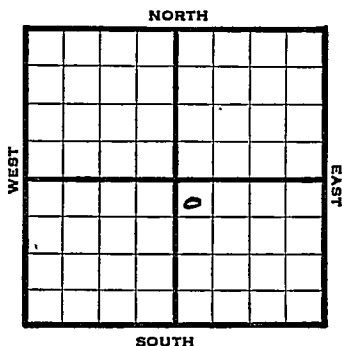

NW SE

1946

Elev. 1902 REPORT

10/16

Lans 3090'
BKC 3338'
Cong 3353
3370 in Cong.
TD 3370'

FIRST REPORT
+
ABANDONED

Map No. 55 Sec. 10 Twp. 16 R. 12WWell No. 2 ChristiansBlack-Marshall


Company

FIRST REPORT

Contractor

NW SE

SECTION PLAT

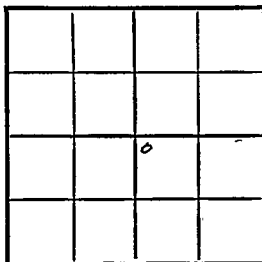330 Ft. from N. Line Ft. from S. Line Ft. from E. Line330 Ft. from W. Line

Barton County

Location Rig up

Drilling and Remarks:

RECORD

Cased in., ft.Sand Gas Oil Total Depth

PRODUCTION

1st 24 hrs. Nat. 1st 24 hrs. after shot Gas Cu. Ft.Dry Hole Abandoned

Date

9/111946S. J. LEWIS

Scout

KANSAS Kansas Pool Name Kraft-Prusa PoolMap No. 55 Sec. 10 Twp. 16 R. 12WWell No. 2 ChristiansBlack-Marshall

Company

ABANDONED

Contractor

NW SE

E11902

SECTION PLAT

		6	

330 Ft. from N. Line Ft. from S. Line Ft. from E. Line330 Ft. from W. LineBarton County

Location

Rig up

Drilling and Remarks:

Home 8090BK 2338Core 33583370 in Core

RECORD

Cased in, ft.Sand Gas Oil Total Depth 3370

PRODUCTION

1st 24 hrs. Nat. 1st 24 hrs. after shot Gas Cu. Ft.Dry Hole Abandoned

Date

SEP 25 1946

19

S. J. LEWIS

Scout

Find this one

check we do
not show A
well here

Advise

Sam

Misc. Small Maps	<i>OK</i>
Cards	<i>Done</i>
Tracing	<i>OK</i>
France Map	<i>OK</i>
Scarborough Map	<i>OK</i>
Pierce Map	<i>OK</i>
Geological Dept.	
Pierce Plat Book	