

Section 24 Township 25 Range 13E

Well No. ~~1~~ <sup># 4</sup> Mills ~~1~~

Company Empire Oil



Sec. 24 Twp. 25 R. 13 E ✓

Well No. # 4 Mills  
~~# 5 Mills "A"~~ Farm

Sheedy et al  
~~Empire Oil~~ Company


Contractor

Ft. from N. Line

700 Ft. from S. Line

Ft. from E. Line

1000 Ft. from W. Line

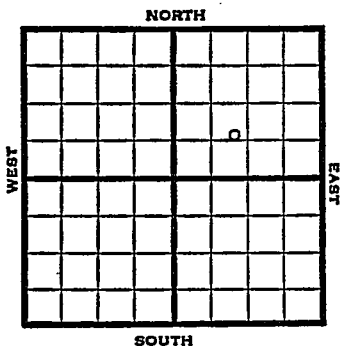

NE SW NE

1951

Elev. - REPORT

4/4

R U R

5/2

Oil Well TD 1510

12" @ 140 10" @ 790

Bart 1480-1502

TD 1510 5" @ 1480

80 qt Comp. 8 Bopd

**COMPLETE**

County **Woodson** State **Kansas**

Sec. **24** (Blk. Twp.) **25** (Sur. Rge.) **13E** Map No.

Operator **Empire Oil**

Well No. **5** Farm **Mills "A"**

Elev. Location **NE SW NE**

			0		
<b>FIRST REPORT</b>					

**700** Ft. From **S** Line **NE**

**1000** Ft. From **W** Line **Quarter**

Ist. Report **APR 4 1951**

Completion

Remarks

Spudding Date

Drig. Data

**R U R**

Kansas

Map No. \_\_\_\_\_ Sec. 24 Twp. 25 R. 13EWell No. 4 MillsSheedy et al.

Company

**CORRECTION**

Contractor

NE SW NE

## SECTION PLAT

		o	

\_\_\_\_\_ Ft. from N. Line

700 Ft. from S. Line

\_\_\_\_\_ Ft. from E. Line

1000 Ft. from W. LineWoodson County

Location \_\_\_\_\_

Rig up \_\_\_\_\_

Drilling and Remarks:

Reported

Empire Oil

#5 Mills "A"

## RECORD

Cased \_\_\_\_\_ in., \_\_\_\_\_ ft.

Sand \_\_\_\_\_

Gas \_\_\_\_\_

Oil \_\_\_\_\_

Total Depth: \_\_\_\_\_

## PRODUCTION

1st 24 hrs. Nat. \_\_\_\_\_

1st 24 hrs. after shot \_\_\_\_\_

Gas \_\_\_\_\_ Cu. Ft.

Dry Hole \_\_\_\_\_

Abandoned \_\_\_\_\_

Date

APR 11 1951

19

J. E. TYRA

Scout

