


Section 21 Township 25 Range 13E

Well No. 7 S. S. Mills "A"

Company Bird-Hanley-Sheedy

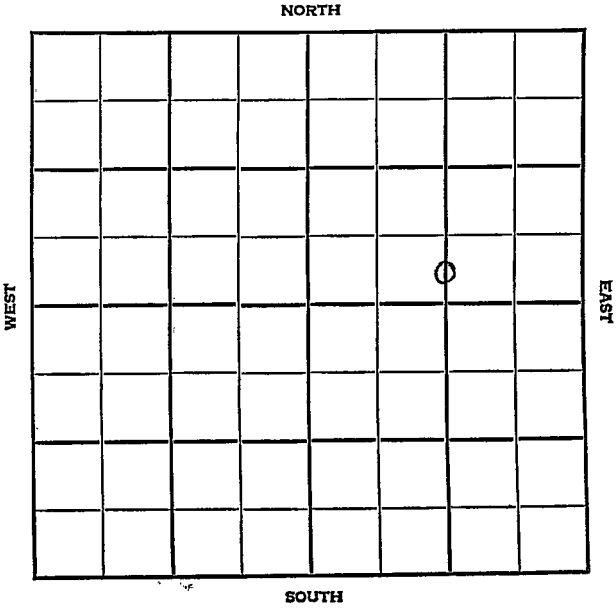

SEC.	TWP.	R.
24	25	13E

WELL NO.

7 S. S. Mills "A"

FARM

COMPANY

Bird-Hanley-Sheedy

CONTRACTOR

Schafges-Kimsey


Quincy

_____ Ft. from N. Line

_____ Ft. from S. Line

_____ Ft. from E. Line

_____ Ft. from W. Line

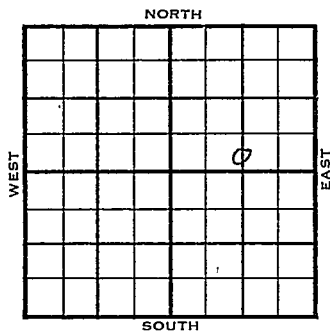C $S\frac{1}{2}$ $S\frac{1}{2}$ NE

1955	ELEVATION	REPORT
------	-----------	--------

7/27 Comm 6-20-55
 12" @ 140
 10" @ 780
 8" @ 1130
 Bart 1454
 7" @ 1469
 TD 1521
 195 qt
 Comp 5 bopd

County Woodson Elev. _____
 Sec. 24 Twp. 25 Rge. 13E
 Company Bird-Hanley-Sheedy
 FarmName S. S. Mills "A" No. 7

TOPS	DEPTH	LOG	DATUM
Anh.			
Tp.			
H.			
Tr.			
Dg.			
Bl.			
L.			
K.C.			
B.K.C.			
Ce.			
C.			
M.			
M.			
K.			
Mz.			
Me.			
V.			
S.			
S.			
A.			
R.			
PE.			
G.			
T.D.			

Loc. in Sec. C S $\frac{1}{2}$ S $\frac{1}{2}$ NE

Geol. _____
 Contr. Schafges
Kimsey
 Pool _____
Quincy

FIRST REPORT
 JUL 27 '55

Date Comm. 6-20-55
12" @ 140 10" @ 780 8" @ 1130
Bart. 1454 7" @ 1469 TD 1521
196 qt/ Comp. 5 bopd

Co.
 Lse.
 No.
 Sec.
 T.
 R.