


Section 11 Township 16 Range 12W

Well No. 1 Thill

Company Advance Drlg.

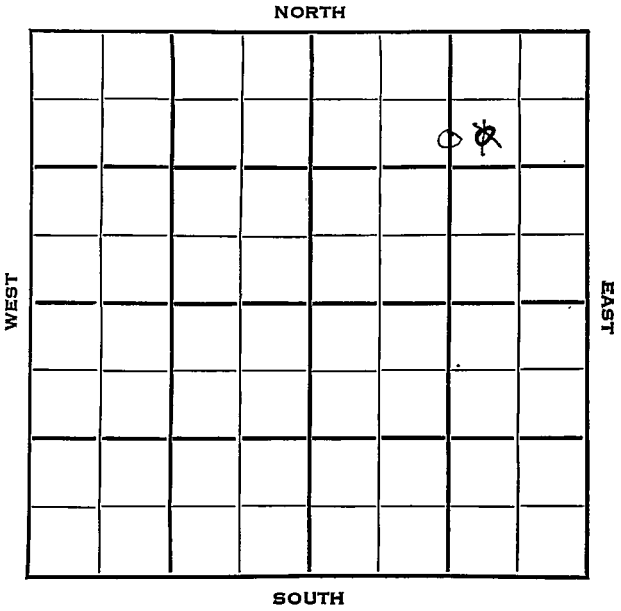

KANSAS

Barton

SEC.	TWP.	R.
11	16	12W

WELL NO.

#1 Thill

FARM

COMPANY

Advance Drlg.

CONTRACTOR

Advance Drlg.

Kraft-Prusa Pool

990

Ft. from N. Line


Ft. from S. Line

~~990~~

1320

Ft. from E. Line

Ft. from W. Line

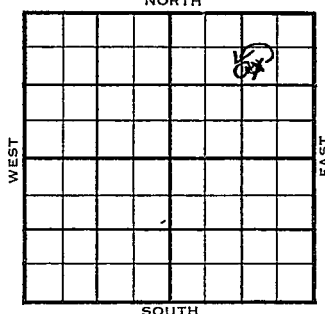

c 5/2 N/2 NE
~~SW NE NE~~

	ELEVATION	REPORT
1954	1910'	

4/21

Spud 4-6-54
 12" @ 465'
 10" @ 772'
 Anhy 772'
 Drlg 1460'

5/5

Top 2683'
 Drlg. 2825'

5/12

Dodge 2981 Lans 3055
 5" @ 3232'

5/19

Arb. 3351 TD 3380 5" @ 3362

6/9

Spud 4-6-54 D & A TD 3380'
 12" @ 465' 10" @ 772' Anhy 772'
 Top. 2683 Dodge 2981' Lans 3055'
 Arb. 3351 TD 3380 5" @ 3362 CO
 to 3380' HFW D & A

ABANDONED

County Barton State KansasSec. 11 (Blk.) 16 (Sur.) 12W Map No.Operator Advance Drlg.Well No. 1 Farm ThillElev. Location SW NE NE

FIRST REPORT

990 Ft. From N Line NE990 Ft. From E Line Quarter1st. Report APR 21 1954

Completion

Remarks

Advance Drlg. - Contr.Spudding Date 4-6-54Drlg. Data Kraft-Prusa Pool12" @ 465 10" @ 772 Anhy 772drlg. 1460

J. G. McGEHEE

KANSAS

Map No. _____ Sec. 11 Twp. 16 R. 12WWell No. 1 Thill

Advance Drlg.

Company

CORRECTION

Contractor

C $S\frac{1}{2}$ $N\frac{1}{2}$ NE

SECTION PLAT

990 Ft. from N. Line

_____ Ft. from S. Line

1320 Ft. from E. Line

_____ Ft. from W. Line

			0

Barton County

Location _____

Rig up _____

Drilling and Remarks:

Reported
SW NE NE

RECORD

Cased _____ in., _____ ft.

Sand _____

Gas _____

Oil _____

Total Depth _____

PRODUCTION

1st 24 hrs. Nat. _____

1st 24 hrs. after shot _____

Gas _____ Cu. Ft.

Dry Hole _____

Abandoned _____

Date

APR 28 1905

19

J. G. McGEHEE


Scout

County Barton State Kansas
 Sec. 11 (Blk. 16) (Sur. 12W) (Rge.) Map No.

Operator Advance Drlg.

Well No. 1 Farm Thill

Elev. 1910 Location C S $\frac{1}{2}$ N $\frac{1}{2}$ NE

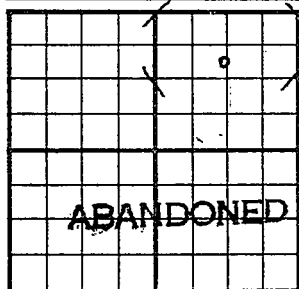

990 Ft. From N Line NE

1320 Ft. From E Line Quarter

1st. Report

Completion JUN 9 1954

Remarks Kraft-Pnusa Pool

Advance Drlg. - Contr.

Spudding Date 4-6-54

Drlg. Data D & A TD 3380

12" @ 465 10" @ 772 Anhy 772

Top. 2683 Dodge 2981 Lans. 3055

Arb. 3351 TD 3380 5" @ 3362 CO to

105380' HFW

D & A

J. G. MCGEE