

DX 78-1

Section 24 Township 24 Range 13EWell No. 1 RheaCompany Sauder & Jones

NORTH

	0						

WEST

EAST

SOUTH

Woodson KANSAS

SEC.	TWP.	R.
24	24	13E

WELL NO.

1 Rhea

FARM

COMPANY

Sauder & Jones

CONTRACTOR

Co. tools


Wintersheid Pool

990 Ft. from N. Line

Ft. from S. Line

Ft. from E. Line

990 Ft. from W. Line

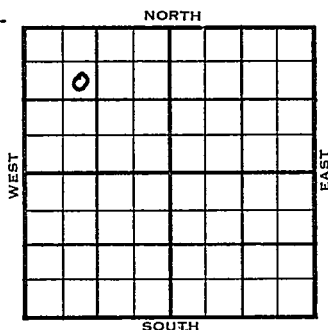

SE NW NW

ELEVATION

REPORT

1954

7/21
8-11

RUST
 Spdg 7-21-54
 Oil well
 TD 1632
 10" @ 789
 8" @ 1175
 Miss 1591
 TD 1632
 4" @ 1627
 CO to 1632 frac Comp. 25bopd

COMPLETED

J. G. McGEHEE

County Woodson State Kansas
 Sec. 24 (Blk.) 24 (Sur.) 13E Map No.
 Operator Sauder & Jones
 Well No. 1 Farm Rhea
 Elev. Location SE NW NW

0							
COMPLETE							

990 Ft. From N Line NW
990 Ft. From W Line Quarter
 1st. Report
 Completion AUG 11 1954
 Remarks Wintersheid Pool
Co. tools
 Spudding Date 7-21-54

Drlg. Data Oil well TD 1632
10" @ 789 8" @ 1175 Miss. 1591
TD 1632 4" @ 1627 CO to 1632 frac
Comp. 25 bopd