


Section 12 Township 24 Range 13E

Well No. #1 Kimbell

Company Jones Construction

Miscellaneous NORTH

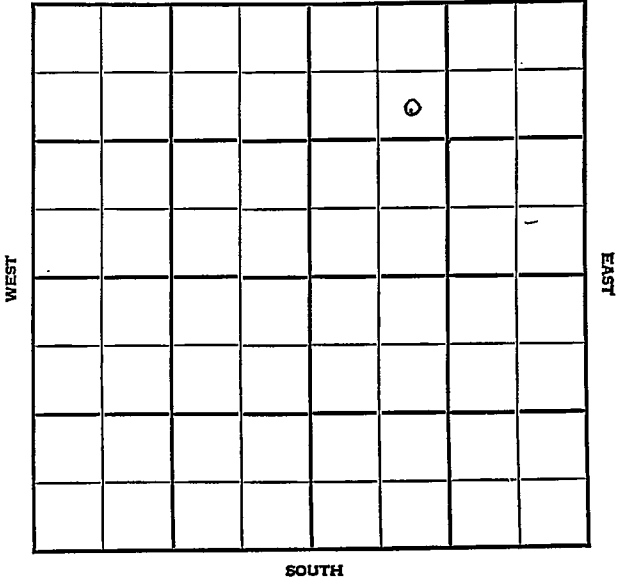

KANSAS

Woodson ✓

Sec. 12 Twp. 24 R. 13E

Well No. #1 Kimbell Farm

Jones Construction Company


Miscellaneous

990' Ft. from N. Line

_____ Ft. from S. Line

_____ Ft. from E. Line

990' Ft. from W. Line

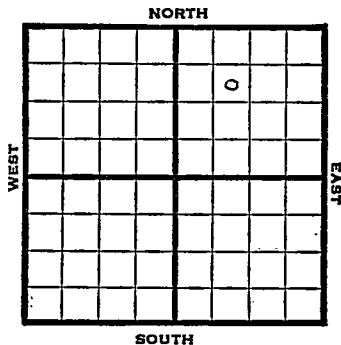

SE NW NE

1948 REPORT

3/31 Twin Well
 4/7 10" @ 395'
 Drlg. 910'
 4/14 8" @ 102'
 Drlg. 1420'
 4/21 "
 4/28 "
 5/5 "
 5/12 "
 5/19 "
 5/26 Miss 1703'
 5" @ 1712'
 10 qts
 Acid 5000
 Pump 5 oil & 20 W Pot.
 Gr. 38°
 TD 1720'

COMPLETED

Map No. _____ Sec. 12 Twp. 24 R. 13EWell No. 1 Kimbell

_____ Jones Construction _____ Company

FIRST REPORT _____ Contractor

SE NW NE

SECTION PLAT

990 Ft. from N. Line

_____ Ft. from S. Line

_____ Ft. from E. Line

990 Ft. from W. LineWoodson County.Location X

Rig up _____

Drilling and Remarks:

twin well

RECORD

Cased _____ in., _____ ft.

Sand _____

Gas _____

Oil _____

Total Depth _____

PRODUCTION

1st 24 hrs. Nat. _____

1st 24 hrs. after shot _____

Gas _____ Cu. Ft.

Dry Hole _____

Abandoned _____

Date

MAR 31 1948 19 S. J. LEWIS Scout

Map No. 17 Sec. 12 Twp. 24 R. 13E

Well No. 1 Kimbell

Jones Construction Company

COMPLETE Contractor

SE NW NE

SECTION PLAT

990 Ft. from N. Line

 Ft. from S. Line

 Ft. from E. Line

990 Ft. from W. Line

		o	

Woodson County

Location

Rig up

Drilling and Remarks:

Misc 1702
5" @ 1712.
1095.
5000 cu ft
Pump oil + 20W
OK 38 2/3

RECORD

Cased in., ft.

Sand

Gas

Oil

Total Depth 1220

PRODUCTION

1st 24 hrs. Nat.

1st 24 hrs. after shot

Gas Cu. Ft.

Dry Hole

Abandoned

Date

MAY 26 1948 19 S. J. LEWIS Scout