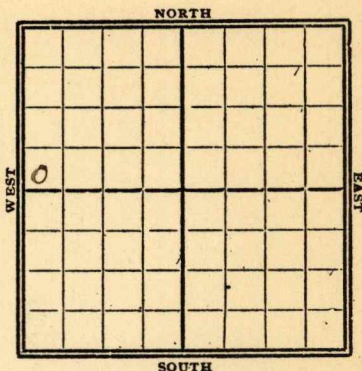


Map No. **KANSAS** Sec. 24 Twp. 28 R. 11Well No. 1 - Batesman Farm
Benge et al Company

.....Ft. from N. Line

300 Ft. from S. Line

.....Ft. from E. Line

300 Ft. from W. Line1928

Date

REPORT

7/25	Rig in up
8/2	Drlg 250
8/9	" 760
8/16	S.D. 950
8/23	sand 1172-1214
	show oil, will shoot
8/28	shot 40gts Drlg 1385
9/4	Drlg 1435
9/12	sand 1172-1214
	show oil 40/dry
	T.D. - 1435
	Dry & Abandoned

Elk

9 **KANSAS** SEC. 24 TWP. 28 R. 11

WELL NO. 1 Batesman

Benge et al COMPANY

CONTRACTOR

SECTION PLAT

FIRST REPORTS

0			

_____ FT. FROM N. LINE

300 FT. FROM S. LINE

_____ FT. FROM E. LINE

300 FT. FROM W. LINE

LOCATION _____

RIG UP _____

DRILLING AND REMARKS:

Rigging up

RECORD

CASED _____ IN. _____ FT.

SAND _____

GAS _____

OIL _____

TOTAL DEPTH _____

PRODUCTION

1ST 24 HRS. NAT. _____

1ST 24 HRS. AFTER SHOT _____

GAS _____ CU. FT.

DRY HOLE _____

ABANDONED _____

DATE

JUL 25 1928

192

CHAS. L. SHERWOOD

SCOUT

K9 **KANSAS** *74* *78* *11*
 MAP No. _____ SEC. _____ TWP. _____ R. _____
 WELL No. *1* *Datesman*
Bings *et al* _____ COMPANY

CONTRACTOR

SECTION PLAT

0			

COMPLETED

_____ FT. FROM N. LINE

300 _____ FT. FROM S. LINE

_____ FT. FROM E. LINE

300 _____ FT. FROM W. LINE**ABANDONED**

RECORD

LOCATION _____

CASED _____ IN. _____ FT.

RIG UP _____

SAND _____

DRILLING AND REMARKS:

GAS _____

OIL _____

TOTAL DEPTH *1435*

PRODUCTION

1ST 24 HRS. NAT. _____

1ST 24 HRS. AFTER SHOT _____

GAS _____ Cu. Ft.

DRY HOLE ☒ABANDONED ☒

DATE

SEP 12 1928

CHAS. L. SHERWOOD

192

SCOUT