


KANSAS

Barton

Section 11 Township 16 Range 12W

Well No. #3. Weber-"A"

Company Black-Marshall

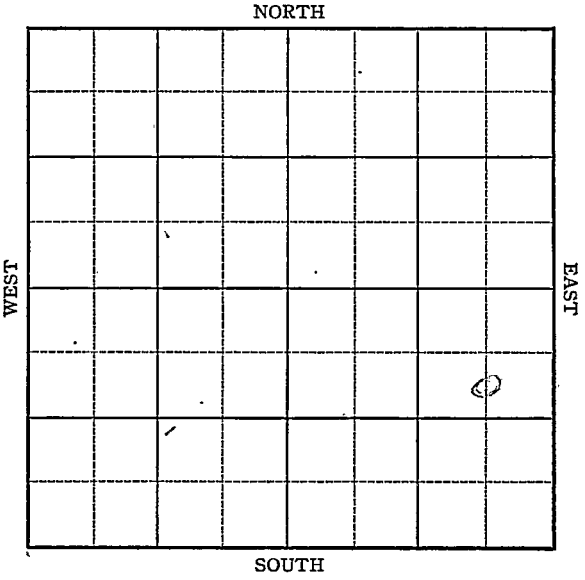

KANSAS Barton

Sec. 11 Twp. 16 R. 12W

Well No. #3 Weber "A" Farm

Black-Marshall Company

Feltes


990 Ft. from N. Line

_____ Ft. from S. Line

660 Ft. from E. Line

_____ Ft. from W. Line

Elev. 1902

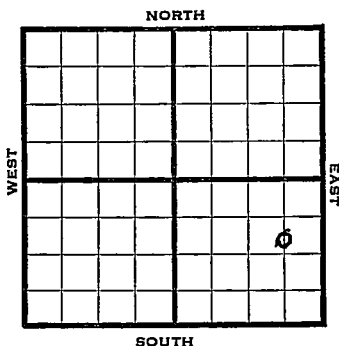

1944

REPORT

7/19 Location

7/26 "

8/2 265 Run csg/

8/9 8" @ 265

Topeka 2675

Drig. 3071

8/16 Lans 3056

BKG 3289

Arb. 3318

TD 3320

5" @ 3319 RUST

8/23 TD 3322 Pump 168 oil in 8 hrs.

8/30 Arb 3318

5" @ 3319

Depth Pot. 6072

Max 3000

TD 3320

Grav. 41.4

COMPLETED

Pool Name Feltes

KANSAS

Map No. 55 Sec. 11 Twp. 16 R. 12W

Well No. 3 Weber "A"

Black-Marshall Company

FIRST REPORT Contractor

C S L N E S E

SECTION PLAT

990 Ft. from N. Line

 Ft. from S. Line

660 Ft. from E. Line

 Ft. from W. Line

			o

Barton County

Location X

Rig up

Drilling and Remarks:

RECORD

Cased in., ft.

Sand

Gas

Oil

Total Depth

PRODUCTION

1st 24 hrs. Nat.

1st 24 hrs. after shot

Gas : Cu. Ft.

Dry Hole

Abandoned

Date

JUL 1 9 1944 19

S. J. LEWIS Scout

Pool Name Feltes Pool

Map No. 55 Sec. 11 Twp. 16 R. 12W

Well No. 3 Beber "A"

Black-Marshall Company

COMPLETED Contractor

C S L N E S E

SECTION PLAT

990 Ft. from N. Line

 Ft. from S. Line

660 Ft. from E. Line

 Ft. from W. Line

Barton

Location

Rig up

Drilling and Remarks:

Cor 83318
5' 23319
Dept 1102 X 6072
Max 8000

41 4/8

RECORD

Cased in., ft.

Sand

Gas

Oil

Total Depth 3320

PRODUCTION

1st 24 hrs. Nat.

1st 24 hrs. after shot

Gas Cu. Ft.

Dry Hole

Abandoned

Date

AUG 30 1944

19

S. J. LEWIS Scout