


Map No. 55 Sec. 1 Twp. 28 R. 12
 Well No. 1 - Crum Farm
Victor Swanson Company

NORTH

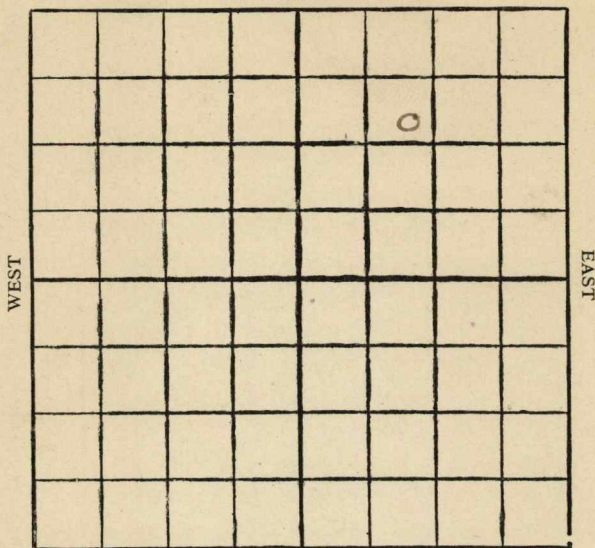

SOUTH

Location

Drilling Remarks

Rig Up

Drilling Remarks

RECORD

Cased in. ft.

Sand

Gas

Oil

Total Depth

PRODUCTION

1st 24 hrs. Nat.

1st 24 hrs. after shot

Gas cu. ft.


Dry Hole

Abandoned

*Greenwood*Map No. *K5* Sec. *1* Twp. *28* R. *12*Well No. *1- Crum* Farm*Victor Swanson* Company*1120* Ft. from N. Line

Ft. from S. Line

Ft. from E. Line

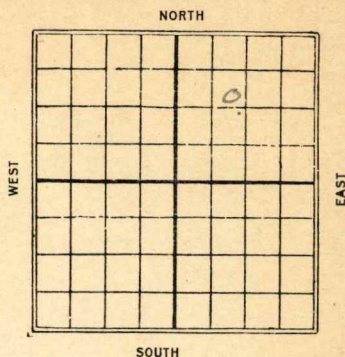1120 Ft. from W. Line*1926*

Date

REPORT

<i>12/22</i>	<i>Spudding</i>
<i>12/30</i>	<i>Spudded & S.D.</i>
<i>1927</i>	
<i>1/6</i>	<i>same</i>
<i>1/13</i>	—
<i>1/19</i>	—
<i>1/26</i>	—
<i>2/3</i>	—
<i>2/10</i>	—
<i>4/17</i>	—
<i>4/24</i>	<i>S.D. 800</i>
<i>3/2</i>	—
<i>3/9</i>	—
<i>3/16</i>	—
<i>3/24</i>	<i>S.D. 800 - (to sell acreage)</i>
<i>3/30</i>	—
<i>4/7</i>	—
<i>4/13</i>	—
<i>4/20</i>	—
<i>4/27</i>	—
<i>5/5</i>	—
<i>5/12</i>	—
<i>5/18</i>	—

5/25 - S.D. 800

6/1 —

6/7 —

6/15 —

6/22 —

6/29 —

7/7 —

7/13 - S.D. 1600

7/20 —

7/28 —

8/4 —

8/10 —

8/18 —

8/24 —

9/1 - Lva. 1600'

K9 KANSAS

Map No. _____ Sec. 1 Twp. 28 R. 12Well No. 1 Victor Swenson Company _____

Contractor _____

COMPLETED**SECTION PLAT**

		o	

1120 Ft. from N. Line

_____ Ft. from S. Line

_____ Ft. from E. Line

1120 Ft. from W. Line**ABANDONED**

Location _____

Rig up _____

Drilling and Remarks:

Sept 17 1600**RECORD**

Cased _____ in., _____ ft.

Sand _____

Gas _____

Oil _____

Total Depth 1600**PRODUCTION**

1st 24 hrs. Nat. _____

1st 24 hrs. after shot _____

Gas _____ Cu. Ft.

Dry Hole ☒Abandoned ☒

Date

SEP 1 - 1927

CHAS. L. SHERWOOD

192

Scout

9 **KANSAS** *Steenwood*
 Map No. _____ Sec. *1* Twp. *28* R. *12*
 Well No. *1* *@rum*
Victor Swanson Company

Contractor _____

FIRST REPORTS**SECTION PLAT***1120* Ft. from N. Line

_____ Ft. from S. Line

_____ Ft. from E. Line

1120 Ft. from W. Line

		o	

Location _____

Rig up _____

Drilling and Remarks:

*Spudding***RECORD**

Cased _____ in., _____ ft.

Sand _____

Gas _____

Oil _____

Total Depth _____

PRODUCTION

1st 24 hrs. Nat. _____

1st 24 hrs. after shot _____

Gas _____ Cu. Ft.

Dry Hole _____

Abandoned _____

Date

DEC 22 1926**CHAS. L. SHERWOOD**

192

Scout