

KANSAS

FORM 51 5M 4-41 PETROL


Barton

Section 11 Township 16 Range 12-W

Well No. 1 Weber "B"

Company Lario

NORTH Beaver pool

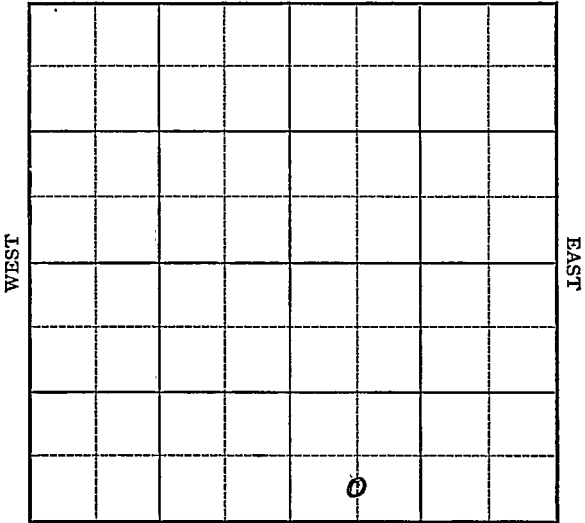

SOUTH

Map No. K-55 Sec. 11 Twp. 16 R. 12W

Well No. 1 Weber "B"


Lario Company

Contractor

FIRST REPORT

C SL SW SE

SECTION PLAT

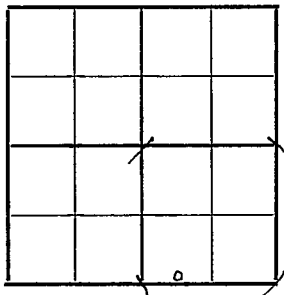

_____ Ft. from N. Line

330 Ft. from S. Line

_____ Ft. from E. Line

660 Ft. from W. Line

BEAVER POOL

Location _____

Rig up _____

Drilling and Remarks:
Derrick

RECORD

Cased _____ in., _____ ft.

Sand _____

Gas _____

Oil _____

Total Depth _____

PRODUCTION

1st 24 hrs. Nat. _____

1st 24 hrs. after shot _____

Gas _____ Cu. Ft.

Dry Hole _____

Abandoned _____

Date

OCT 1 1941 19

S. J. LEWIS Scout

Barton

KANSAS

Map No. K-55 Sec. 11 Twp. 16 R. 12WWell No. 1 Weber "B"Lario

Company

ABANDONED

Contractor

C SL SW SE

_____ Ft. from N. Line

330 Ft. from S. Line

_____ Ft. from E. Line

660 Ft. from W. Line

SECTION PLAT

BEAVER POOL

Location _____

Rig up _____

Drilling and Remarks:

*Cor 8 3368**Water.*

RECORD

Cased _____ in., _____ ft.

Sand _____

Gas _____

Oil _____

Total Depth 3378

, PRODUCTION

1st 24 hrs. Nat. _____

1st 24 hrs. after shot _____

Gas _____ Cu. Ft.

Dry Hole _____

Abandoned _____

Date

NOV 5 1941 19

S. J. LEWIS

Scout