

Greenwood


KANSAS


Form 51-5M 5-37 Petrol

Section 2 Township 28 Range 12-E

Well No. 1 - Burns

Company Davy et al

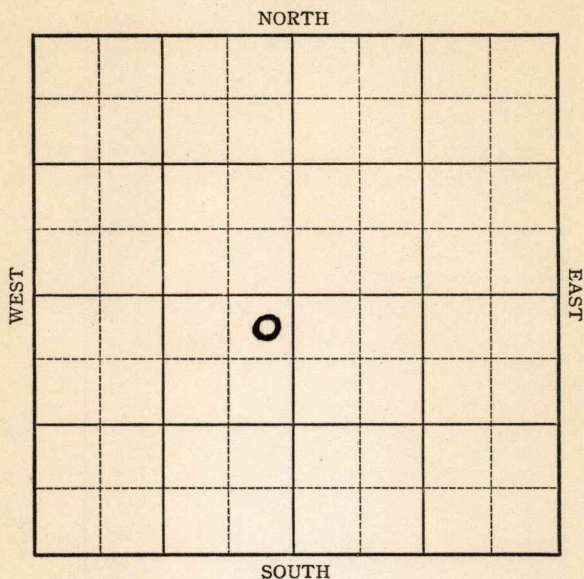

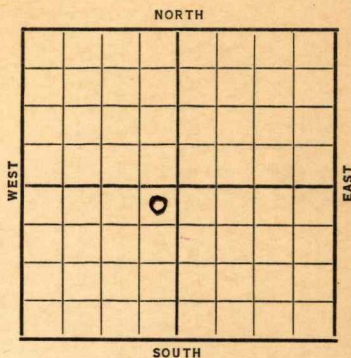Sec. 2 Twp. 28 R. 12-EWell No. #1 Burns FarmDavy etal Company330 Ft. from N. Line Ft. from S. Line330 Ft. from E. Line Ft. from W. Line

Date

REPORT

1937

7/28

Spud

7/30

"

8/6

"

8/13

10" @ 200'. Drlg. 503'.

8/20

Drlg. 650'.

8/28

8" @ 718'. Drlg. 1064'.

9/1

Miss 1565'.

No shows oil.

T.D. 1604'.

ABANDONED

KANSAS

Greenwood

Map No. 9 Sec. 2 Twp. 28 R. 12 EWell No. 1 - BurnsDavy Company

Contractor

ABANDONED

SECTION PLAT

	0		

330 Ft. from N. Line

_____ Ft. from S. Line

330 Ft. from E. Line

_____ Ft. from W. Line

Location _____

Rig up _____

Drilling and Remarks:

RECORD

Cased _____ in., _____ ft.

~~Sand~~ MISS 1565~~Gas~~ NO SHOWS OIL

Oil _____

Total Depth 1604

PRODUCTION

1st 24 hrs. Nat. _____

1st 24 hrs. after shot _____

Gas _____ Cu. Ft.

Dry Hole _____

Abandoned _____

Date

SEP 1 1937 19

H. D. Hatfield Scout

Map No. 9 Sec. 2 Twp. 28 R. 12 ^E

Well No. 1 - Burns

Davy et al Company
Contractor

FIRST REPORT

330 Ft. from N. Line

540 Ft. from S. Line

330 Ft. from E. Line

 Ft. from W. Line

SECTION PLAT

	0		

Location

Rig up

Drilling and Remarks:

Spud

RECORD

Cased in., ft.

Sand

Gas

Oil

Total Depth

PRODUCTION

1st 24 hrs. Nat.

1st 24 hrs. after shot

Gas Cu. Ft.

Dry Hole

Abandoned

Date

JUL 28 1937 19

H. D. Hatfield Scout