


Section 12 Township 16 Range 12W

Well No. #1 Dolecheck (B) (KGS DRL)

Company Ed Bradley

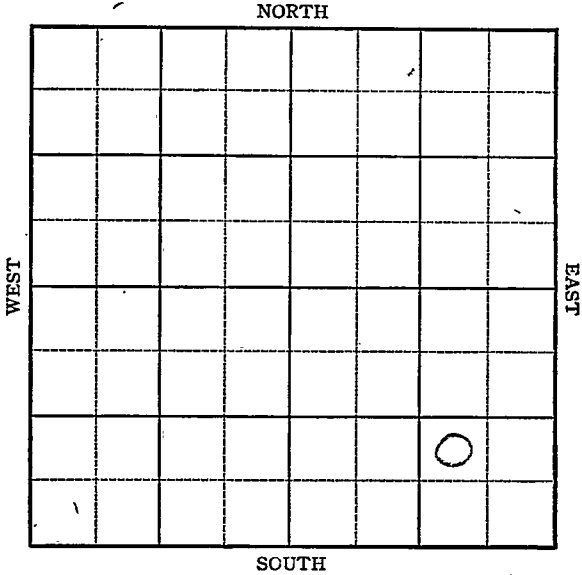

KANSAS

Barton County

Sec. 12 Twp. 16S R. 12W

Well No. #1² Dolecheck (B) (KGS PRL) Farm

Ed Bradley Company

NW SE SE

Ft. from N. Line


990

Ft. from S. Line

990

Ft. from E. Line

Ft. from W. Line

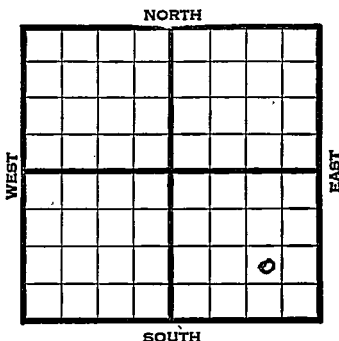

Edw. 1888

1945

REPORT

4-4 - Set 8" @ 428
Drilling 3154

4/12 Arb 3308

5" @ 3308

TD 3311 600' oil 1 hr.

" " " " "

4/20 Swab 28 oil per hr 1000 acid.

4/27 Arb 3308

5/9 5" @ 3308

TD 3311

1000 acid.

Echo Pot. 2671

Grav. 42.6

COMPLETED

Pool Name Kraft-PrusaMap No. 155 Sec. 12 Twp. 16 R. 12WWell No. 1² Dolecheck 'B' (KGS DRL)Ed Bradley Company

FIRST REPORT

Contractor

NW SE SE

SECTION PLAT

_____ Ft. from N. Line

990 Ft. from S. Line990 Ft. from E. Line

_____ Ft. from W. Line

Barton

Location _____

Rig up _____

Drilling and Remarks:

8" - 428

3154

RECORD

Cased _____ in., _____ ft.

Sand _____

Gas _____

Oil _____

Total Depth _____

PRODUCTION

1st 24 hrs. Nat. _____

1st 24 hrs. after shot _____

Gas _____ Cu. Ft.

Dry Hole _____

Abandoned _____

Date

APR 4 1945 19S. J. LEWIS Scout

