


Barton

Section 12 Township 16 Range 12W

Well No. #1 Holder \_\_\_\_\_

Company Phillips

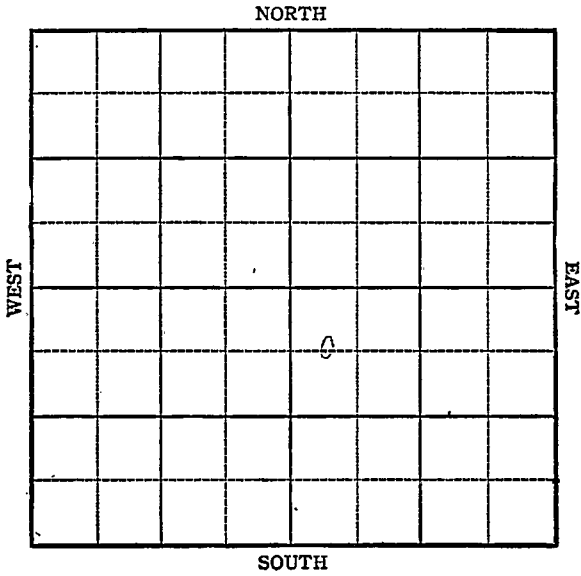

Sec. 12 Twp. 16 R. 12W

Well No. #1, Holder Farm

Phillips Pet. Company

Feltes


NORTH

660 Ft. from N. Line

\_\_\_\_\_ Ft. from S. Line

\_\_\_\_\_ Ft. from E. Line

330 Ft. from W. Line

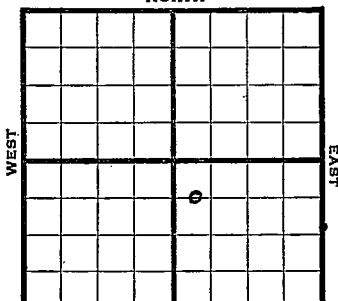

SOUTH

1944

REPORT

6/14 Location

6/21 "

6/28 "

7/12 8" @ 490 WOC

7/19 Lans 3030

Drlg 3065

7/26 Arb. 3300

TD 3306 5" @ 3298 RUST

8/2 " " " " " "

8/9 2630' oily cut mud 1 hr.

8/16 " " " " " "

8/23 Arb. 3300

5" @ 3298

Echo Pot. 2866 oil plus 89 wtr.

TD 3306

Grav. 42.

COMPLETED

**KANSAS**

Pool Name Feltes

Map No.      Sec. 12 Twp. 16 R. 12W

Well No. 1 Holder

Phillips

Company

**FIRST REPORT**

Contractor

**C W L NW SE**

**SECTION PLAT**

660 Ft. from N. Line

\_\_\_\_\_ Ft. from S. Line

\_\_\_\_\_ Ft. from E. Line

330 Ft. from W. Line


**Barton County**

Location X

Rig up \_\_\_\_\_

Drilling and Remarks:

**RECORD**

Cased \_\_\_\_\_ in., \_\_\_\_\_ ft.

Sand \_\_\_\_\_

Gas \_\_\_\_\_

Oil \_\_\_\_\_

Total Depth \_\_\_\_\_

**PRODUCTION**

1st 24-hrs. Nat. \_\_\_\_\_

1st 24 hrs. after shot \_\_\_\_\_

Gas \_\_\_\_\_ Cu. Ft.

Dry Hole \_\_\_\_\_

Abandoned \_\_\_\_\_

Date

JUN 1 4 1944 19

S. J. LEWIS Scout

Pool Name FeltesMap No. 55 Sec. 12 Twp. 16 R. 12WWell No. 1 HolderPhillips

Company

**COMPLETED**

Contractor

C W L NW SE

## SECTION PLAT

		o	

660 Ft. from N. Line         Ft. from S. Line         Ft. from E. Line330 Ft. from W. LineBarton CountyLocation         Rig up         

Drilling and Remarks:

CE 833005' @ 3298Ech for P 286600+ 89 Water.42 2/3

## RECORD

Cased          in.,          ft.Sand         Gas         Oil         Total Depth 3306

## PRODUCTION

1st 24 hrs. Nat.         1st 24 hrs. after shot         Gas          Cu. Ft.Dry Hole         Abandoned         

Date

AUG 23 194419S. J. LEWIS

Scout