


Butler
Map No. Ks Sec. 25 Twp. 29 R. 3E
Well No. 1-Smythe Farm
Boyle et al Company

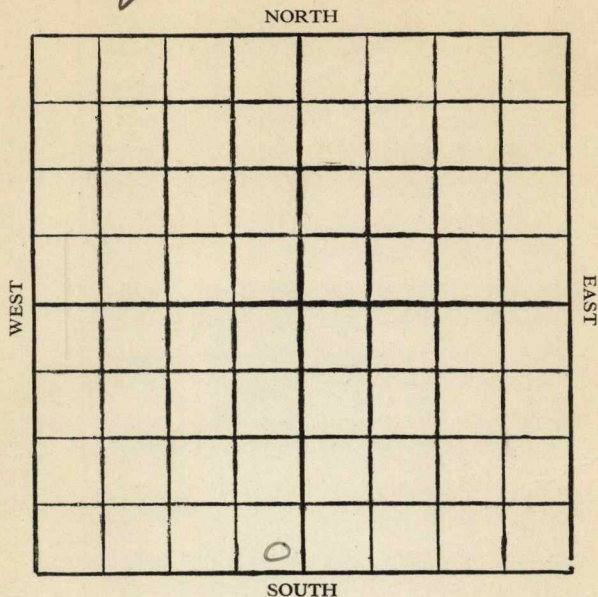

Location

Drilling Remarks

Rig Up

Drilling Remarks

RECORD

Cased in. ft.

Sand

Gas

Oil

Total Depth

PRODUCTION

1st 24 hrs. Nat.

1st 24 hrs. after shot

Gas cu. ft.

Dry Hole

Abandoned


Butler

Map No. Kansas Sec. 25 Twp. 29 R 3EWell No. 1 Smyth Farm
Boyle et al Company

Ft. from N. Line

300 Ft. from S. Line300 Ft. from E. Line

Ft. from W. Line

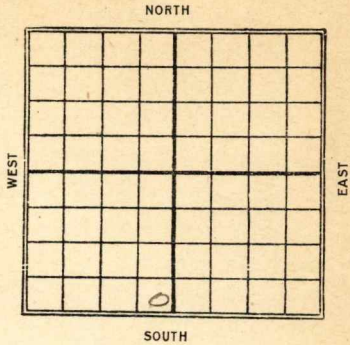

Date

REPORT

<u>1926</u>	
<u>12/29</u>	<u>Rig</u>
<u>1927</u>	
<u>1/5</u>	<u>no report</u>
<u>1/12</u>	<u>—</u>
<u>1/19</u>	<u>Drlg 300</u>
<u>1/26</u>	<u>" 700</u>
<u>2/2</u>	<u>" 1250</u>
<u>2/9</u>	<u>T.D. 1675 - S.D.</u>
<u>2/16</u>	<u>—</u>
<u>2/23</u>	<u>—</u>
<u>3/2</u>	<u>—</u>
<u>3/9</u>	<u>—</u>
<u>3/16</u>	<u>—</u>
<u>3/23</u>	<u>—</u>
<u>3/30</u>	<u>—</u>
<u>4/6</u>	<u>Drlg 1980</u>
<u>4/13</u>	<u>Run 8" @ 2300</u>
<u>4/20</u>	<u>Drlg 2360</u>
<u>4/27</u>	<u>T.D. 2360 - S.D.</u>
<u>5/4</u>	<u>Drlg 2450</u>
<u>5/11</u>	<u>" 2970</u>
<u>5/25</u>	<u>S.D. 3085</u>
<u>6/11</u>	<u>Drlg 3140</u>

6/8 - Ardg 3200

6/15 - " 3300

6/22 - T.D. 3517

D + H.

Map No. 12 **KANSAS** Sec. 25 Twp. 29 R. 3E

Well No. 1 Smyth

Boyle & Co. Company

Contractor

SECTION PLAT

----- Ft. from N. Line

200 Ft. from S. Line

200 Ft. from E. Line

----- Ft. from W. Line

FIRST REPORTS

Location -----

Rig up -----

Drilling and Remarks:

Rig

RECORD

Cased ----- in., ----- ft.

Sand -----

Gas -----

Oil -----

Total Depth -----

PRODUCTION

1st 24 hrs. Nat. -----

1st 24 hrs. after shot -----

Gas ----- Cu. Ft.

Dry Hole -----

Abandoned -----

Date

DEC 29 1926

S. J. LEWIS

192

Scout

Map No. 12 KANSAS Sec. 25 Twp. 29 R. 3E

Well No. 1 Smith

Boyle & Co Company

Contractor

SECTION PLAT

----- Ft. from N. Line

300 Ft. from S. Line

300 Ft. from E. Line

----- Ft. from W. Line

ABANDONED

Location -----

Rig up -----

Drilling and Remarks:

T/D 3517

D & A.

RECORD

Cased ----- in., ----- ft.

Sand -----

Gas -----

Oil -----

Total Depth -----

PRODUCTION

1st 24 hrs. Nat. -----

1st 24 hrs. after shot -----

Gas ----- Cu. Ft.

Dry Hole -----

Abandoned -----

Date

JUN 22 1927

192

S. J. LEWIS Scout

MAP NO. **KANSAS** SEC. 75 TWP. 59S R. 3E

WELL NO. B. G. & M. Co

COMPANY

CONTRACTOR

SECTION PLAT

ABANDONED

_____ FT. FROM N. LINE

_____ FT. FROM S. LINE

_____ FT. FROM E. LINE

_____ FT. FROM W. LINE

LOCATION _____

RIG UP _____

DRILLING AND REMARKS:

RECORD

CASED _____ IN. _____ FT.

SAND _____

GAS _____

OIL _____

TOTAL DEPTH 3517

PRODUCTION

1ST 24 HRS. NAT. _____

1ST 24 HRS. AFTER SHOT _____

GAS _____ Cu. Ft.

DRY HOLE ☒

ABANDONED ☒

DATE


Jun 21 1927

SCOUT

Butter

Map No. Kansas Sec. 25 Twp. 29 R 3EWell No. 1 Smyth FarmBoyle et al Company

NORTH

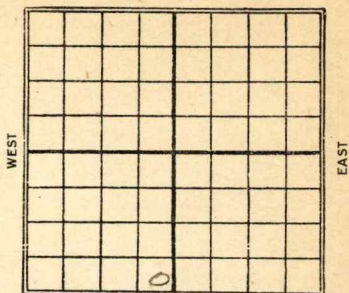

SOUTH

Ft. from N. Line

300 Ft. from S. Line300 Ft. from E. Line

Ft. from W. Line

Date

REPORT

192612/29Rig19271/5no report1/12—1/19Drlg 3001/26" 7002/2" 12502/9T.D. 1675. S.D.2/16—2/23—3/2—3/9—3/16—3/23—3/30—4/6Drlg 19804/13Run 8" @ 23004/20Drlg 23604/27T.D. 2360 - S.D.5/4Drlg 24505/11" 29705/25S.D. 30856/11Drlg 3140