


KANSAS

Section 12 Township 16 S Range 12 W

Well No. ~~#1~~ ³ ~~#2~~ Dolecheck "B" ^A (KGS DRL)

Company ED BRADLEY

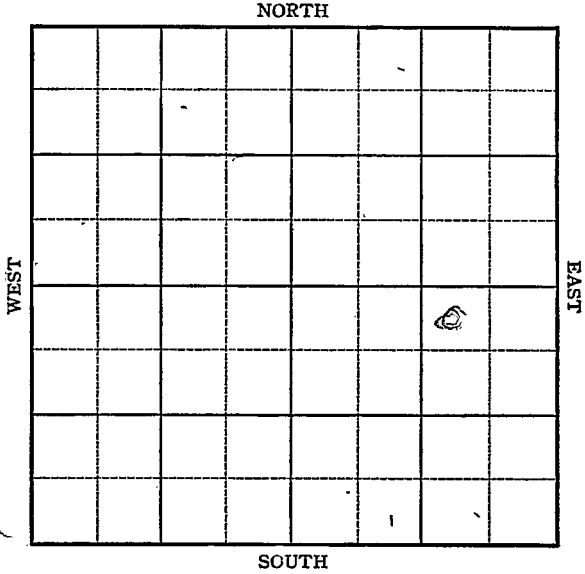

KANSAS Barton County

Sec. 12 Twp. 16 R. 12W

Well No. #2³ Dolecheck (B) - (KLS DRL) Farm

Ed Bradley Company


Kraft-Prusa

330 Ft. from N. Line

_____ Ft. from S. Line

990 Ft. from E. Line

_____ Ft. from W. Line

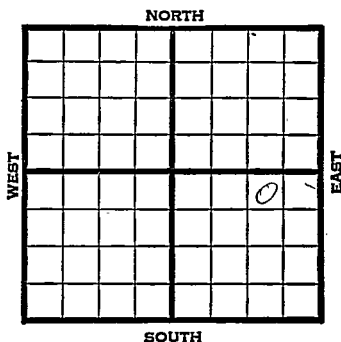

NW NE SE

REPORT

1945 Elev. 1887

4/11 Location

4/20 "

4/27 8" @ 240

Arb 3365-3375

TD 3375

5" @ 3250' RUST

5/3 " " " "

5/10 " " " "

5/17 " " " "

5/24 47 shots 3180-3188

4000 acid.

Swab 6 oil per hr

5/29 Lens 3048

5" @ 3350

TD 3375

47 shots 3180-3188

4000 acid.

Pump 235 Pot.

Grav. 42.0

COMPLETED

Kansas Pool Name Kraft-PrusaMap No. 55 Sec. 12 Twp. 16 R. 12WWell No. 23 Dolecheck (B) (KGS DRL)Ed Bradley Company

FIRST REPORT

Contractor

NW NE SE

SECTION PLAT

330 Ft. from N. Line

Ft. from S. Line

990 Ft. from E. Line

Ft. from W. Line

			o

Barton

Location X

Rig up _____

Drilling and Remarks:

RECORD

Cased _____ in., _____ ft.

Sand _____

Gas _____

Oil _____

Total Depth _____

PRODUCTION

1st 24 hrs. Nat. _____

1st 24 hrs. after shot _____

Gas _____ Cu. Ft.

Dry Hole _____

Abandoned _____

Date

APR 11 1945 19S. I. LEWIS Scout

Kansas Pool Name Kraft-Prusa

Map No. 55 Sec. 12 Twp. 16 R. 12W

Well No. 23 Dolecheck 'B' (K195 DRL)

Ed Bradley Company

COMPLETED

Contractor

NW NE SE

E 11879
SECTION PLAT

330 Ft. from N. Line

_____ Ft. from S. Line

990 Ft. from E. Line

_____ Ft. from W. Line

			o

Barton County

Location _____

Rig up _____

Drilling and Remarks:

*Line 3048.
5 to 3358
47 & 1/2 to 3180 - H
4000 cu ft
Pump 235 P.S.T
42 gals*

RECORD

Cased _____ in., _____ ft.

Sand _____

Gas _____

Oil _____

Total Depth 3270

PRODUCTION

1st 24 hrs. Nat. _____

1st 24 hrs. after shot _____

Gas _____ Cu. Ft.

Dry Hole

Abandoned

Date

MAY 29 1945

19

S. J. LEWIS Scout

Kansas Pool Name Kraft-Prusa

Map No. 15 Sec. 13 Twp. 16 R. 12W

Well No. #2 Dolecheck "A" (KGS DRL)

Ed Bradley etal Company

CORRECTION

Contractor

NW NE

SECTION PLAT

330 Ft. from N. Line

_____ Ft. from S. Line

_____ Ft. from E. Line

330 Ft. from W. Line

		o	

Barton County

Location _____

Rig up _____

Drilling and Remarks:
reported as
#2 Dolecheck

RECORD

Cased _____ in., _____ ft.

Sand _____

Gas _____

Oil _____

Total Depth _____

PRODUCTION

1st 24 hrs. Nat. _____

1st 24 hrs. after shot _____

Gas _____ Cu. Ft.

Dry Hole _____

Abandoned _____

Date

JUN 13 1945

19

S. J. LEWIS

Scout