


Section 32 Township 29 Range 3-E

Well No. #1 Keller

Company Texas

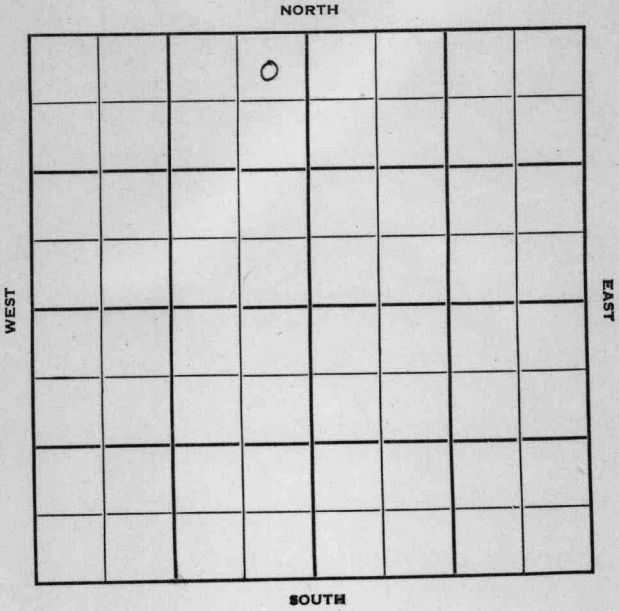

Sec. 32 Twp. 29 R. 3-E

Well No. #1 Keller Farm

Texas Company

Contractor

Wildcat


330 Ft. from N. Line

Ft. from S. Line

330 Ft. from E. Line

Ft. from W. Line

NE NE NW

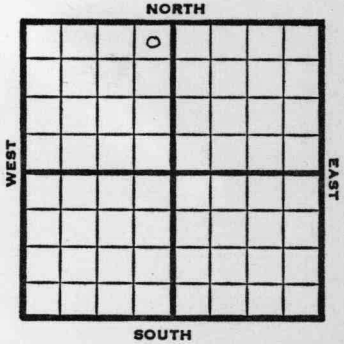

1950

Elev 1263

REPORT

8/2 cellar & pits

8/23 10" @ 188

Heeb 1810

Doug 1920

Lans 2085

KC 2431

Miss 2941

Simp 3294

Arb 3297

DST 3295-3307 opn 1 3/4 hr rec 30' ocm

66' wtr

TD 3345

D&A

ABANDONED

KANSAS

Map No. _____ Sec. 32 Twp. 29 R. 3E

Well No. 1 Keller

Texas

Company _____

Contractor _____

NE NE NW

SECTION PLAT

330 Ft. from N. Line

_____ Ft. from S. Line

330 Ft. from E. Line

_____ Ft. from W. Line

		0	
FIRST REPORT			

Butler County

Location _____

Rig up _____

Drilling and Remarks:

Cellar & pits

RECORD

Cased _____ in., _____ ft.

Sand _____

Gas _____

Oil _____

Total Depth _____

PRODUCTION

1st 24 hrs. Nat. _____

1st 24 hrs. after shot _____

Gas _____ Cu. Ft.

Dry Hole _____

Abandoned _____

Date

AUG 2 1930

J. E. TYRA

Scout

County Butler State Kansas

Sec. 32 (Blk. 29) (Sur. 3E) Map No.

Operator Texas

Well No. 1 Farm Keller

Elev. 1263 Location NE NE NW

		<u>0</u>			
ABANDONED					

330 Ft. From N Line NW

330 Ft. From E Line Quarter

1st. Report

Completion AUG 23 1950

Remarks

Wildcat

Spudding Date 8-5-50

Drig. Data D & A TD 3345

10" @ 188 Heeb. 1810 Doug. 1920

Lans. 2085 KC 2431 Miss. 2941

Simp. 3294 Arb. 3297 DST 3295-3307

open 1 3/4 hr. Rec. 30' ocm 66' water

TD 3345 D & A

J. E. TYRA