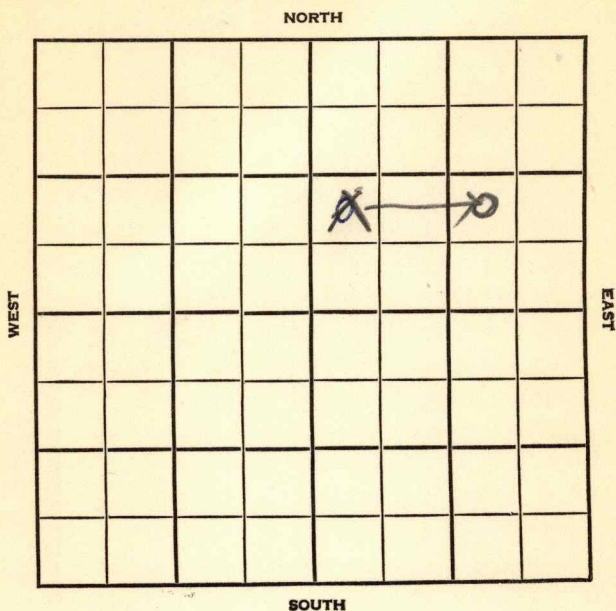


Section 32 Township 29 Range 3 EWell No. #1 PearsonCompany Time Pet.

Butler

KANSAS

SEC.

32

TWP.

29

R.

3E

WELL NO.

##1 Pearson

FARM

COMPANY

#Time Petroleum

CONTRACTOR

Kirkpatrick


WILDCAT

_____ Ft. from N. Line

_____ Ft. from S. Line

_____ Ft. from E. Line

_____ Ft. from W. Line

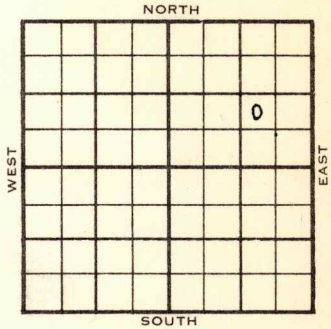

NW SE NE

1956

ELEVATION

REPORT

2-15

8" @ 150/150
RUR

County Rutler Elev. 3E
 Sec. 32 Twp. 29 Rgr. 3E
 Company Time Petroleum
 Farm Name Pearson No. 1

TOPS	DEPTH	LOG	DATUM	Loc. in Sec.
Anh.				NW SE NE
TP.				
H.				
Tr.				
Dg.				
Bl.				
L.				Geol.
K.C.				Contr.
B.K.C.				Kirkpatrick
Ce.				Pool
C.				Wildcat
M.				
M.				
K.				
Mz.				
Mq.				
V.				
S.				
S.				
A.				
R.				
PE.				
G.				
T.D.				

Date Comm.

8" @ 150/150 RUR

FEB 15 '56		

FIRST REPORT

County Butler Elev 1279
 Sec. 32 Twp 29 Rge 3E
 Company Time Petroleum
 Farm Name Pearson No. 1

TOPS	DEPTH	LOG	DATUM	Loc. in Sec.
Ant.				NW SE NE
Tr.				
H. <u>stall</u>	<u>2124</u>		<u>845</u>	
Tr.				
Op.				
Bl.				
L.				
K.C.	<u>2335</u>		<u>1056</u>	Geol.
B.K.C.				Cont.
Ce.				<u>Kirkpatrick</u>
C.				
M.	<u>2954</u>		<u>1675</u>	
M.				Pool
K.	<u>3191</u>		<u>1912</u>	
No. <u>chata</u>	<u>3231</u>		<u>1952</u>	<u>Wildcat</u>
No.				
V.				
S.				
S.				
A.	<u>3320</u>		<u>2041</u>	
R.				
Pe.				
G.				ABANDONED
SD	<u>3420</u>			

Date Comm.

FEB 29 1956

8" @ 150/150

RUR

FEB 22 '56

LOST CIRC.

@ 3058

FEB 29 '56

No Log

N & A