
FORM 51 5M 11-44 PETROL

KANSAS Barton county

Section 12 Township 16 Range 12W

Well No. #5, Weber

Company J. Bergman

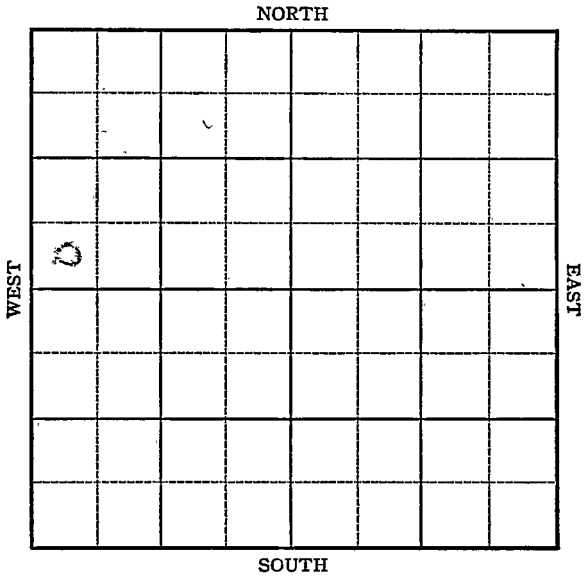

FORM 252-A
5M 12-45 PETROL

KANSAS Barton County

Sec. 12 Twp. 16 R. 12W

Well No. #5 Weber Farm

J. Bergman Company

Kraft-Prusa


_____ Ft. from N. Line

330 Ft. from S. Line

_____ Ft. from E. Line

330 Ft. from W. Line

SW NW

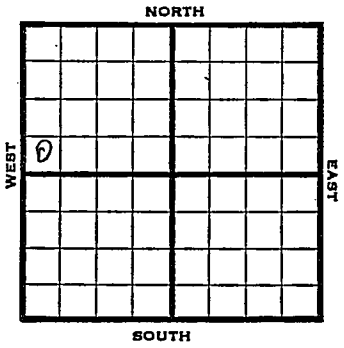

1946	Elev 1898' REPORT
5/15	Surface Hole
5/21	8" @ 394 Anhy 705' Drlg 2346'
5/29	Lans 3062 Arb. 3327-3329 TD 3329' 5" @ 3327' RUST
6/5	10 shots 3324-3326 20 shots 3326-3328 PB
6/19	Lans 3062' Arb 3327' 5" @ 3327 Perf Lans 1000 acid Pump 393 Pot 42.0 Gr TD 3329'

COMPLETED

FORM 26 200 BKS. 2-44 PETROL

Kansas Pool Name Kraft-Prusa

Map No. KANSAS Sec. 12 Twp. 16 R. 12W


Well No. 5 Weber

J. Bergman Company

FIRST REPORT Contractor

SW NW

SECTION PLAT

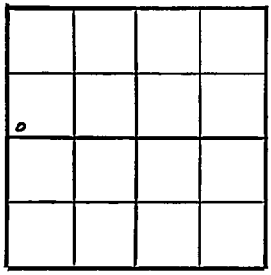

____ Ft. from N. Line

330 Ft. from S. Line

____ Ft. from E. Line

330 Ft. from W. Line

Barton County

Location

Rig up

Drilling and Remarks:

Surface Hole

RECORD

Cased ____ in., ____ ft.

Sand

Gas

Oil

Total Depth

PRODUCTION

1st 24 hrs. Nat.

1st 24 hrs. after shot

Gas ____ Cu. Ft.

Dry Hole

Abandoned

Date

MAY 15 1946 19 S. J. LEWIS Scout

FORM 26 200 BKS. 2-44 PETROL

KANSAS Kansas Pool Name Kraft-Prusa Pool

Map No. 55 Sec. 12 Twp. 16 R. 12W

Well No. 5 Weber


J. Bergman Company

COMPLETED Contractor

SW NW

E. 1898

SECTION PLAT

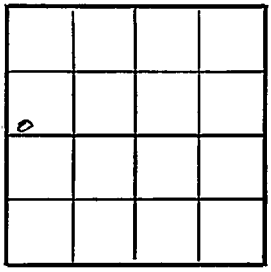

____ Ft. from N. Line

330 Ft. from S. Line

____ Ft. from E. Line

330 Ft. from W. Line

Barton County

Location

Rig up

Drilling and Remarks:

Lans 3062

Ark 3327

5" @ 3327

Perf Lans.

1000 acid

Pump 8 98 BO

42 Gr

RECORD

Cased ____ in., ____ ft.

Sand

Gas

Oil

Total Depth 3329

PRODUCTION

1st 24 hrs. Nat.

1st 24 hrs. after shot

Gas Cu. Ft.

Dry Hole

Abandoned

Date

JUN 19 1946 19

S. J. LEWIS Scout