

Map No. _____ Sec. 5 Twp. 29 R. 2

Well No. 7 Kruger Farm

Besse & Davidson Company

Kansas Wyoming etc

A blank 8x8 grid with a central vertical line and a central horizontal line. The grid is divided into four 4x4 quadrants. The letters 'W', 'E', 'S', and 'O' are placed at the intersections of the central lines with the grid edges: 'W' on the left, 'E' on the right, 'S' at the bottom, and 'O' at the top.

Location -----

Drilling Remarks:

Rig Up -----

Drilling Remarks:

COMPLETED

RECORD

Cased ----- in.-----ft.

Sand -----

Gas _____

Oil _____

Total Depth.....

PRODUCTION

1st 24 hrs. Nat.-----

1st 24 hrs. after shot-----

Gas ----- cu. ft.

Dry Hole -----

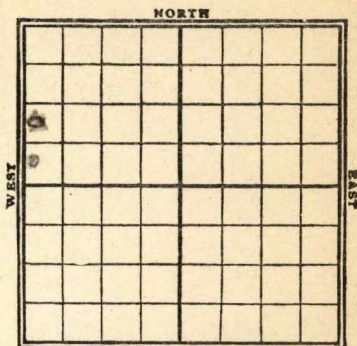
Abandoned -----

Map No. _____ Sec. 2 Twp. 29 R. 4Well No. 3 Krueger Farm
Benedict & Davidson company
~~Kansas Wyoming~~

_____ Ft. from N. Line

550 Ft. from S. Line

_____ Ft. from E. Line

200 Ft. from W. Line

SOUTH

FIRST REPORT

REPORT

COMPLETED

1917
Date

12/17 Rig up

1/17/20 Rig

23 Rig up.

29 ✓

2/2 Spud

11 Spud & SW

29 SW for 10" - 16 10'

3/4 10 2005'

23 ✓ 2750'

4/2 ✓ 3100'

9 3105-08- 2000' oil in hole

27 3105-08- 8000'.

Map No. K 11 Sec. 2 Twp. 29 R. 4Well No. 2 KuegerBenedum & Davidson Company

Contractor

SECTION PLAT

Ft. from N. Line

550 Ft. from S. Line

Ft. from E. Line

200 Ft. from W. Line

0			

FIRST REPORT

Location

Rig up ☒

Drilling and Remarks:

RECORD

Cased _____ in., _____ ft.

Sand _____

Gas _____

Oil _____

Total Depth _____

PRODUCTION

1st 24 hrs. Nat. _____

1st 24 hrs. after shot _____

Gas _____ Cu. Ft.

Dry Hole _____

Abandoned _____

Date

12/17 1919

Pyle

Scout

Map No. K11 Sec. 2 Twp. 29 R. 4Well No. 3 KruegerKansas Wyoming Oil Company

Contractor

SECTION PLAT

Ft. from N. Line

550' Ft. from S. Line

Ft. from E. Line

200' Ft. from W. Line

0			

CHANGE LESSEE NAME
from Krueger to Pyle

Location

Rig up

Drilling and Remarks:

Change number
from #2

RECORD

Cased _____ in., _____ ft.

Sand _____

Gas _____

Oil _____

Total Depth _____

PRODUCTION

1st 24 hrs. Nat. _____

1st 24 hrs. after shot _____

Gas _____ Cu. Ft.

Dry Hole _____

Abandoned _____

Date

1/2 1919 Pyle Scout

Map No. K 11 Sec. 2 Twp. 29 R. 4Well No. 3 KreugerKansas Wyoming Company

Contractor

SECTION PLAT

Ft. from N. Line

550 Ft. from S. Line

Ft. from E. Line

200 Ft. from W. Line

●			

Location

Rig up

Drilling and Remarks:

RECORD

Cased _____ in., _____ ft.

Sand 3105-3108

Gas _____

Oil _____

Total Depth _____

PRODUCTION

1st 24 hrs. Nat. 80 bbls

1st 24 hrs. after shot _____

Gas _____ Cu. Ft.

Dry Hole _____

Abandoned _____

Date

4/27 1920

Pyle

Scout