


Kansas

Map No. _____ Sec. *1* Twp. *29* R. *4*

Well No. *1 Guthrie* Farm _____

_____ Company _____

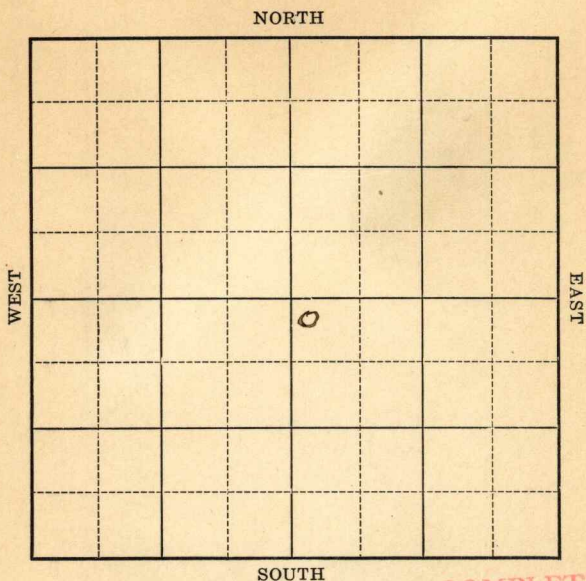

COMPLETED

Location _____

Rig Up _____

Drilling Remarks:

Drilling Remarks:

RECORD

PRODUCTION

Cased _____ in. _____ ft.

1st 24 hrs. Nat. _____

Sand _____

1st 24 hrs. after shot _____

Gas _____

Gas _____ cu. ft.

Oil _____

Dry Hole _____

Total Depth _____

Abandoned _____

Map No. Kans 11 Sec. 1 Twp. 29 R. 4

Well No. 1 Guthrie
S + S, Company

Contractor

FIRST REPORT

SECTION PLAT

200 Ft. from N. Line

----- Ft. from S. Line

----- Ft. from E. Line
200 Ft. from W. Line

		0	

Location -----

Rig up -----

Drilling and Remarks:

20,1500

RECORD

Cased ----- in., ----- ft.

Sand -----

Gas -----

Oil -----

Total Depth -----

PRODUCTION

1st 24 hrs. Nat. -----

1st 24 hrs. after shot -----

Gas ----- Cu. Ft.

Dry Hole -----

Abandoned -----

Date

JUL 22 1922

M. A. BENEAR

Map No. **KANSAS** 11 Sec. 1 Twp. 29 R. 4

Well No. *1 Guthrie*

S. & S. Company

Contractor

ABANDONED SECTION PLAT

200 Ft. from N. Line
 _____ Ft. from S. Line
 _____ Ft. from E. Line
200 Ft. from W. Line

		0	

Location _____

Rig up _____

Drilling and Remarks:

RECORD

Cased _____ in., _____ ft.
 Sand _____
 Gas _____
 Oil _____
 Total Depth _____

PRODUCTION

1st 24 hrs. Nat. _____
 1st 24 hrs. after shot _____
 Gas _____ Cu. Ft.
 Dry Hole *22* _____
 Abandoned *3360* _____

Date

SEP 16 1922 191

M. A. BENEAR Scout

Butler

K11

MAP NO. **KANSAS** SEC. 1 TWP. 29S R. 4E

WELL NO. 1

*Butcher
Shawver - Butler*

COMPANY

CONTRACTOR

SECTION PLAT

ABANDONED

_____ FT. FROM N. LINE

_____ FT. FROM S. LINE

_____ FT. FROM E. LINE

_____ FT. FROM W. LINE

LOCATION _____

RIG UP _____

DRILLING AND REMARKS:



RECORD

CASED _____ IN. _____ FT.

SAND _____

GAS _____

OIL _____

TOTAL DEPTH 3360

PRODUCTION

1ST 24 HRS. NAT. _____

1ST 24 HRS. AFTER SHOT _____

GAS _____ CU. FT.

DRY HOLE

ABANDONED

DATE

9/4 192 2

SCOUT