

# KANSAS

Form 51-5M-7-40-Palace


Woodson

Section 13 Township 24 Range 13-E

Well No. #17 Rhea

Company Woodson P.L. & Prod.

NORTH Winterscheidt Pool

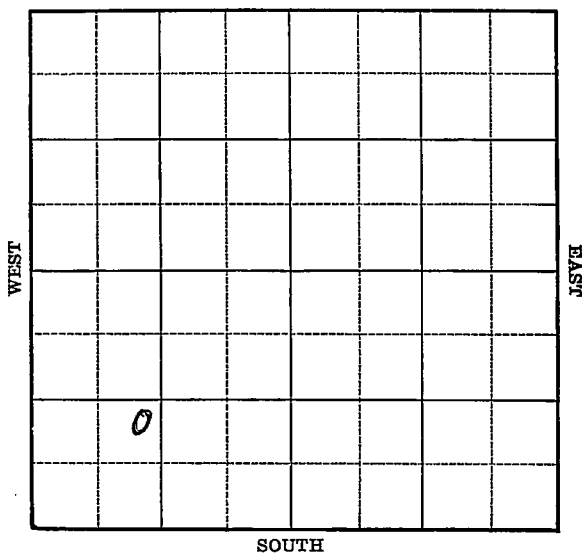



Map No. 17 Sec. 13 Twp. 24 R. 13EWell No. 17 RheaWoodson P.L. & Prod. Company

Contractor


**FIRST REPORT**

NE SW SW

\_\_\_\_\_ Ft. from N. Line

1140 Ft. from S. Line

\_\_\_\_\_ Ft. from E. Line

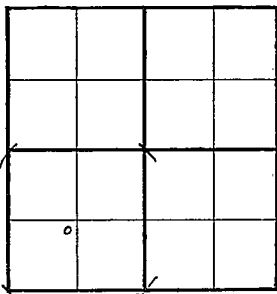1100 Ft. from W. Line**SECTION PLAT**

WINTERSCHIEDT POOL

Location \_\_\_\_\_

Rig up \_\_\_\_\_

Drilling and Remarks:

Machine

**RECORD**

Cased \_\_\_\_\_ in., \_\_\_\_\_ ft.

Sand \_\_\_\_\_

Gas \_\_\_\_\_

Oil \_\_\_\_\_

Total Depth \_\_\_\_\_

**PRODUCTION**

1st 24 hrs. Nat. \_\_\_\_\_

1st 24 hrs. after shot \_\_\_\_\_

Gas \_\_\_\_\_ Cu. Ft.

Dry Hole \_\_\_\_\_

Abandoned \_\_\_\_\_

Date

OCT 9 1940 19

S. J. LEWIS Scout

Map No. 17 Sec. 13 Twp. 24 R. 13E

Well No. 17 Rhea

Woodson P.L. & Prod. Company

Contractor

**COMPLETED**

**SECTION PLAT**

NE SW SW


\_\_\_\_\_ Ft. from N. Line

1140 Ft. from S. Line

\_\_\_\_\_ Ft. from E. Line

1100 Ft. from W. Line

WINTERSCHIEDT POOL

Location \_\_\_\_\_

Rig up \_\_\_\_\_

Drilling and Remarks:

*Miss 1615*  
*6" @ 1618.*  
*609 to 1686-51*  
*Pump 10 5/16"*

**RECORD**

Cased \_\_\_\_\_ in., \_\_\_\_\_ ft.

Sand \_\_\_\_\_

Gas \_\_\_\_\_

Oil \_\_\_\_\_

Total Depth 1654

**PRODUCTION**

1st 24 hrs. Nat. \_\_\_\_\_

1st 24 hrs. after shot \_\_\_\_\_

Gas \_\_\_\_\_ Cu. Ft.

Dry Hole \_\_\_\_\_

Abandoned \_\_\_\_\_

Date

NOV 13 1940 19

S. J. LEWIS Scout