

Hoodson

Map No. KANSAS Sec. 13 Twp. 24 R. 13 E


Well No. H-A Rhea Farm
Reye & Hilby Company

720 Ft. from N. Line

_____ Ft. from S. Line

250 Ft. from E. Line

_____ Ft. from W. Line

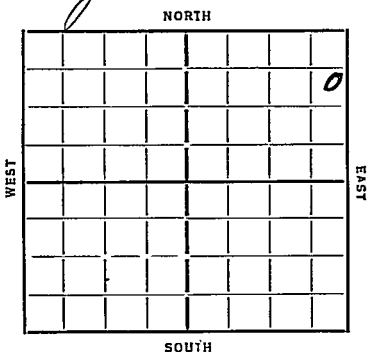

Date 1934

REPORT

12/5 dlg 615

12/19 sh 615

12/21 dlg 1060

12/29 " 1500

1/3/35 _____

1/19 dlg 1615

1/17 WR 6"

1/23 line 1592 T 7/1672 D & A

ABANDONED

Map No. 17 Sec. 13 Twp. 24 R. 13E

Well No. 1A-Rhea

Nye + Kilby Company

Contractor

FIRST REPORTS

SECTION PLAT

720 Ft. from N. Line

..... Ft. from S. Line

250 Ft. from E. Line

..... Ft. from W. Line

			o

Location.....

Rig up.....

Drilling and Remarks:

Deq 615

RECORD

Cased..... in., ft.

Sand.....

Gas.....

Oil.....

Total Depth.....

PRODUCTION

1st 24 hrs. Nat.....

1st 24 hrs. after shot.....

Gas..... Cu. Ft.

Dry Hole.....

Abandoned.....

Date

12-5-34

192.....

ORVAL MANN SCHRECK

Scout

Woodson

Map No. 17 Sec. 13 Twp. 24 R. 13E

Well No. 1A-Rhea

Nye + Kilby Company

Contractor

ABANDONED

SECTION PLAT

720 Ft. from N. Line

..... Ft. from S. Line

250 Ft. from E. Line

..... Ft. from W. Line

			0

Location.....

Rig up.....

Drilling and Remarks:

104A

RECORD

Cased..... in., ft.

Sand lime 1592

Gas.....

Oil.....

Total Depth 1672

PRODUCTION

1st 24 hrs. Nat.....

1st 24 hrs. after shot.....

Gas..... Cu. Ft.

Dry Hole.....

Abandoned.....

Date

1-23-35 192.....

ORVAL MANNSCHRECK

Scout