

State Geological Survey
WICHITA, BRANCH

15-009-21142

KANSAS DRILLERS LOG

API No. 15 — 009 — 21,142
County Number

Operator

Roy Vonfeldt

Address

135 Houten Russell, Kansas 67665

Well No.

#2

Lease Name

Luerman "B" ?

Footage Location

feet from (N) (S) line

feet from (E) (W) line

Principal Contractor

Geologist

Spud Date

Total Depth

P.B.T.D.

Date Completed

Oil Purchaser


Continental oil co

S. 18 T. 16 R. 13 K W

Loc. SE SE SW

County Barton

640 Acres
N

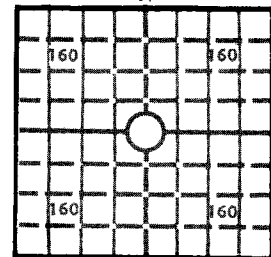

Locate well correctly

Elev.: Gr.

DF

KB

CASING RECORD

Report of all strings set — surface, intermediate, production, etc.

Purpose of string	Size hole drilled	Size casing set (in O.D.)	Weight lbs/ft.	Setting depth	Type cement	Sacks	Type and percent additives

LINER RECORD

Top, ft.	Bottom, ft.	Sacks cement
—	—	—

PERFORATION RECORD

Shots per ft.	Size & type	Depth interval
8 holes		3382 1/2 - 3384 1/2

TUBING RECORD

Size	Setting depth	Packer set at
2"	3378	—

ACID, FRACTURE, SHOT, CEMENT SQUEEZE RECORD

Amount and kind of material used	Depth interval treated
none	
well come in natural	
swabbed 6 barrel of oil on hand no matter	

INITIAL PRODUCTION

Date of first production 3-14-77		Producing method (flowing, pumping, gas lift, etc.) Pumping			
RATE OF PRODUCTION PER 24 HOURS		Oil 30	Gas 2	Water 0	Gas-oil ratio
		bbls.	MCF	bbls.	CFPB
Disposition of gas (vented, used on lease or sold)			Producing interval (s)		

INSTRUCTIONS: As provided in KCC Rule 82-2-125, within 90 days after completion of a well, one completed copy of this Drillers Log shall be transmitted to the State Geological Survey of Kansas, 4150 Monroe Street, Wichita, Kansas 67209. Copies of this form are available from the Conservation Division, State Corporation Commission, 3830 So. Meridian (P.O. Box 17027), Wichita, Kansas 66217. Phone AC 316-522-2206. If confidential custody is desired, please note Rule 82-2-125. Drillers Logs will be on open file in the Oil and Gas Division, State Geological Survey of Kansas, Lawrence, Kansas 66044.


Operator		DESIGNATE TYPE OF COMP.: OIL, GAS, DRY HOLE, SWDW, ETC.:
Well No.	Lease Name	
S _____ T _____ R _____ E _____ W		

WELL LOG

Show all important zones of porosity and contents thereof; cored intervals, and all drill-stem tests, including depth interval tested, cushion used, time tool open, flowing and shut-in pressures, and recoveries.

SHOW GEOLOGICAL MARKERS, LOGS RUN,
OR OTHER DESCRIPTIVE INFORMATION.

FORMATION DESCRIPTION, CONTENTS, ETC.	TOP	BOTTOM	NAME	DEPTH
USE ADDITIONAL SHEETS, IF NECESSARY, TO COMPLETE WELL RECORD.				

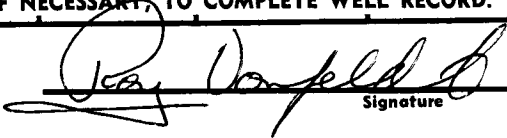Date Received	 Signature
	Title
	Date