


Section 14 Township 24 Range 13E

Well No. #8 Kimbell

Company Nadel & Gussman

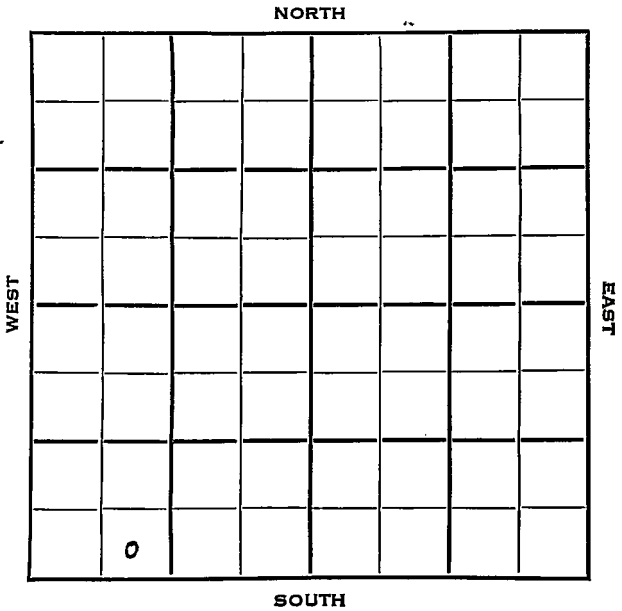


SEC. 14	TWP. 24	R. 13E ✓
------------	------------	-------------

WELL NO. #8 Kimbell FARM
COMPANY

CONTRACTOR Nadel & Gussman

Sauder
Blackwell Pool

_____ Ft. from N. Line
330 _____ Ft. from S. Line
_____ Ft. from E. Line
990 _____ Ft. from W. Line

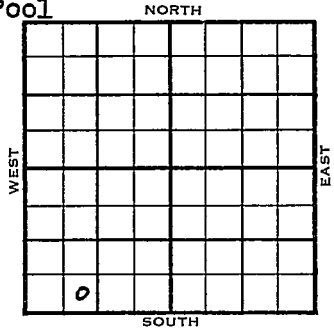

SE SW SW

	ELEVATION	REPORT
--	-----------	--------

1954

2/24

RUST

3/31

Spud 2-23-54 Oil well TD 1643
10" @ 500 Miss. chat 1625
Miss. lime 6137 TD 1643
4" @ 1636 FU 700' oil 12 hr.
Frac. Comp. 25 BOPD

COMPLETED

