


Section 25 Township 26 Range 13E

Well No. 1 Rodgers

Company Charles Davis

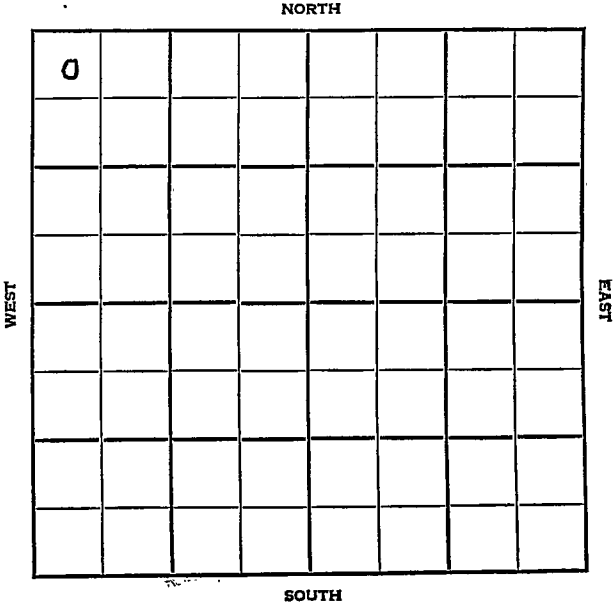

SEC. 25	TWP. 26	R. 13E	✓
------------	------------	-----------	---

WELL NO. #1 Rodgers FARM

COMPANY Charles Davis

CONTRACTOR Co. Tools.


Wildcat.

330 Ft. from N. Line

Ft. from S. Line

Ft. from E. Line

330 Ft. from W. Line

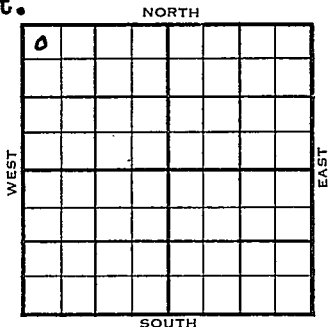

NW NW NW

1954	ELEVATION	REPORT
------	-----------	--------

4/27 RUST

6/23 Spudding 5-2-54
 10" @ 97
 8" @ 400.
 Miss. 1462
 TD1500
 D&A

ABANDONED

County **Woodson** State **Kansas**

Sec. **25** (Blk. Twp.) **26** (Sur. Rge.) **13E** Map No.

Operator **Charles Davis**

Well No. **1** Farm **Rodgers**

Elev. _____ Location **NW NW NW**

0					

330 Ft. From **N** Line **NW**

330 Ft. From **W** Line **Quarter**

1st. Report **APR 27 1954**

Completion _____

Remarks _____

Co. tools

Spudding Date _____

Drlg. Data **Wildcat**

RUST

County Woodson State Kansas
 Sec. 25 (Blk. 2 Twp. 6) (Sur. 13E Rge.) Map No.
 Operator Charles Davis
 Well No. 1 Farm Rodgers

Elev. _____ Location NW NW NW



330 Ft. From N Line NW
330 Ft. From W Line Quarter

Ist. Report _____

Completion JUN 23 1954

Remarks Wildcat

Co. tools

Spudding Date 5-23-54

Drlg. Data _____

10" @ 97 8" @ 400 Miss. 1462 TD 1500

D & A

J. G. McGEHEE