

Woodson

KANSAS

Section 14 Township 24 Range 13EWell No. #4 KimbleCompany Souder Drlg.

NORTH

SOUTH

WEST

EAST

6

Woodson KANSAS

Sec. 14 Twp. 24 R. 13 EWell No. #4 Kimbel Farm

Souder Drlg. Company

Contractor

Ft. from N. Line

990


Ft. from S. Line

330

Ft. from E. Line

Ft. from W. Line

NE SE SW

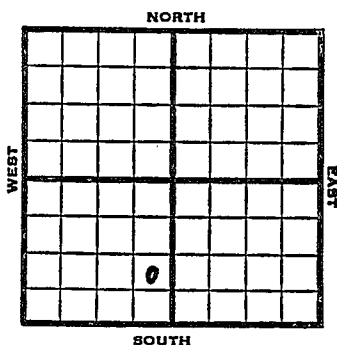

1953

Elev. -

REPORT

1/21

Spud 1-15-53
Drlg. 265'

2/18

Spud 1-15-53
SWD well TD 1692' 8" @ 883
Miss 1650' TD 1692'
Comp. for SWD well.**ABANDONED**

County Woodson State Kansas

Sec. **14** (Blk. Twp.) **24** (Sur. Rge.) **13E** Map No.

Operator Souder D.Lg.

Well No. 1 Farm Kimbel

Elev.	Location	NE	SE	SW
-------	----------	----	----	----

FIRST REPORT

990 Ft. From S Line SW

330 Ft. From E Line Quarter

1st. Report JAN 21 1952

Completion

Remarks

Spudding Date **1-15-53**

Drlg. Data

drlg. 265

J. G. McGEHEE

Map No. _____ Sec. 14 Twp. 24 R. 13E

Well No. 4 Kimbel

Souder Drlg. Company

CORRECTION Contractor

NE SE SW

SECTION PLAT

_____ Ft. from N. Line

990 Ft. from S. Line

330 Ft. from E. Line

_____ Ft. from W. Line

Woodson County

Location _____

Rig up _____

Drilling and Remarks:

Reported
#1 Kimbel

RECORD

Cased _____ in., _____ ft.

Sand _____

Gas _____

Oil _____

Total Depth _____

PRODUCTION

1st 24 hrs: Nat. _____

1st 24 hrs: after shot. _____

Gas _____ Cu. Ft.

Dry Hole _____

Abandoned _____

Date

FEB 25 1953 19

J. G. McGEHEE


Scout

County Woodson State Kansas
 Sec. 14 (Blk. 24) (Sur. 13E) Map No.

Operator Souder Drlg.

Well No. 4 Farm Kimbel

Elev. Location NE SE SW

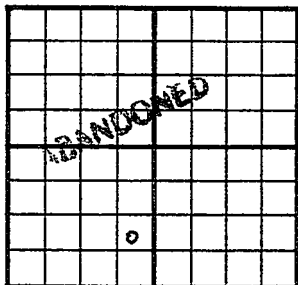

990 Ft. From S Line SW

330 Ft. From E Line Quarter

1st. Report

Completion FEB 18 1953

Remarks

Spudding Date 1-15-53

Drlg. Data SWD well TD 1692

8" @ 883 Miss. 1650 TD 1692

Comp. for SWD well

1st Report shows #1

Your 1st report shows #1

You complete as #4

Advise

Sam

Spot Cards	<i>mm</i>
Land Small Map	
Land Well Map	<i>3</i>
Tracings	
Fringe Map	
Water Map	
NASG	

MAR 2 1953

Orig. Date