

Woodson


FORM 51

KANSAS

Section 14 Township 24 Range 13E

Well No. #7 Kimball

Company Nadel & Gussman

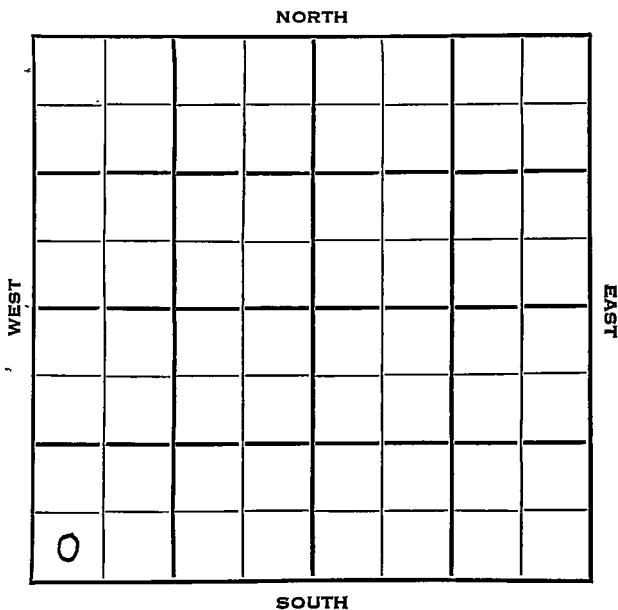

Woodson KANSAS


SEC. 14	TWP. 24	R. 13E ✓
------------	------------	-------------

WELL NO. 7 Kimball FARM

COMPANY Nadel & Gussman

CONTRACTOR Sauder

\_\_\_\_\_ Ft. from N. Line  
 330 \_\_\_\_\_ Ft. from S. Line  
 \_\_\_\_\_ Ft. from E. Line  
 330 \_\_\_\_\_ Ft. from W. Line

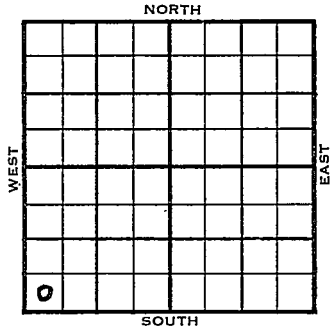

SW SW SW

	ELEVATION	REPORT
1954	=	

2/3 Spud 2-1-54  
 Drilg. 125'

2/24 Spud 2-1-54  
 Oil Well  
 TD 1663'  
 8" @ 920'  
 Miss 1658',  
 4" @ 1658'  
 TD 1663'  
 Comp 35 bopd.

**COMPLETED**



