


Section 21 Township 28 Range 8E

Well No. #16 Ferrell Ranch

Company Table Mesa

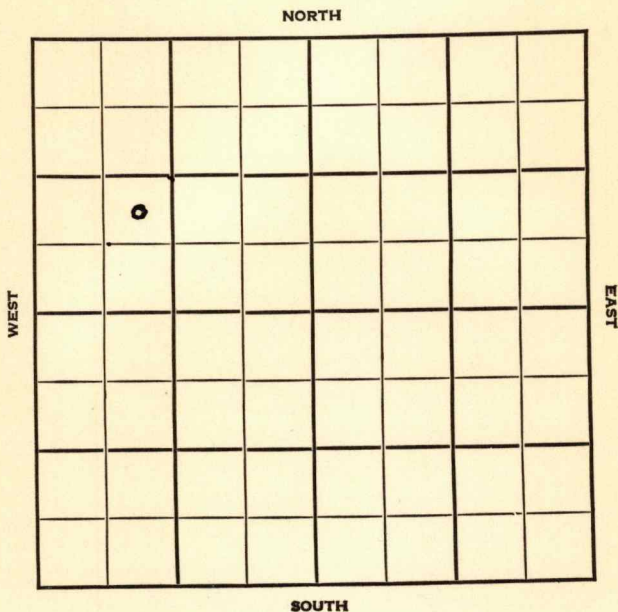

Sec. 21 Twp. 28 R. 8E ✓

Well No. #16 Ferrell Ranch Farm

Table Mesa Company

Misc.


 Ft. from N. Line

990 Ft. from S. Line

 Ft. from E. Line

990 Ft. from W. Line

NE SW NW

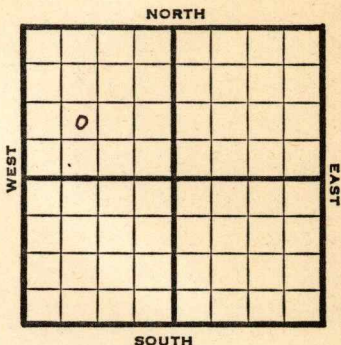

REPORT

1948

1/28 Drlg. 1050'

2/4 Drlg. 1410'

2/11 10" @ 1400'
8" @ 1567'
Drlg. 2095'

2/18 **Mississippi 2721-29'**
TD 2729'
5" @ 2720'
RUST

2/25 **Miss. 2721'**
5" @ 2720'
1000 acid
Pump 25 Pot
38.0 Gr.
TD 2751'
Comp.

COMPLETED

Map No. _____ Sec. 21 Twp. 28 R. 8E

Well No. 16 Ferrell Ranch

Table Mesa Company

FIRST REPORT Contractor

NE SW NW

SECTION PLAT

	o		

_____ Ft. from N. Line

990 Ft. from S. Line

_____ Ft. from E. Line

990 Ft. from W. Line

Butler County

Location _____

Rig up _____

Drilling and Remarks:

drlg. 1050

RECORD

Cased _____ in., _____ ft.

Sand _____

Gas _____

Oil _____

Total Depth _____

PRODUCTION

1st 24 hrs. Nat. _____

1st 24 hrs. after shot _____

Gas _____ Cu. Ft.

Dry Hole _____

Abandoned _____

Date

JAN 28 1948

19

S. J. LEWIS

Scout

