
FORM 51 25M 8-50 WESTERN Barton KANSAS

Section 12 Township 16 Range 12W

Well No. #8 Weber

Company Howard Alexander

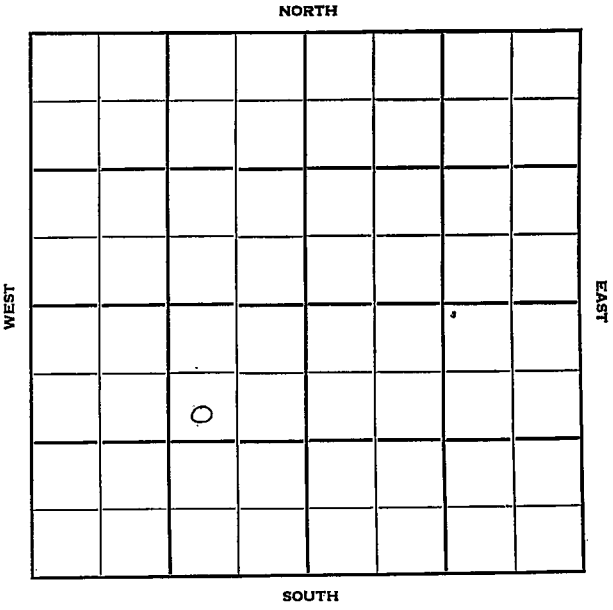

FORM 252-B
10M 11-50 PETROL

Barton KANSAS

Sec. 12 Twp. 16 R. 12W

Well No. #8 Weber Farm

Howard Alexander Company

Mouser Drlg. - Contr. Contractor

Kraft-Prusa Pool


990' Ft. from N. Line

Ft. from S. Line

990' Ft. from E. Line

Ft. from W. Line

SW NE SW

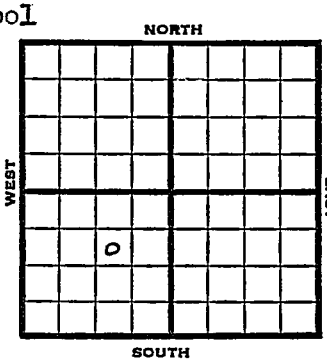

1951	Elev. 1886' REPORT
8/29 12/12	RUR Spud 8-21-51 Oil Well TD 3358 8" @ 400 Anhy 736 DST 2875-89 opn 45 min. Rec. 70' ho & gcm Lans. 3044 DST 3127-41 Rec. 30' mud & sw DST 3216-26 opn 1 hr. Rec. 120' oil TD 3352 5" @ 3350 CO to 3352 wtr PB 3265 Cong. 3310 29/3214-25 3000 A S/10 boph P/25 bopd DD 3358 Gorham sand 3350 HFW PB to KC Comp. 18 bopd 4% wtr. COMPLETED

FORM 275 FOR SALE BY KANSAS BLUE PRINT CO.


County Barton State Kansas

Sec. 12 (Blk. Twp.) 16 (Sur. Rge.) 12W Map No.

Operator Howard Alexander

Well No. 8 Farm Weber

Elev. Location SW NE SW

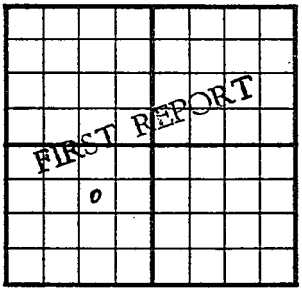

990 Ft. From N Line SW

990 Ft. From E Line Quarter

1st. Report AUG ? 9 1951

Completion

Remarks.

Mouser Drlg. - Contr.

Spudding Date

Drlg. Data Kraft-Prusa Pool

R U R

J. E. TYRA

FORM 275 FOR SALE BY KANSAS BLUE PRINT CO.


County Barton State Kansas

Sec. 12 (Blk. Twp.) 16 (Sur. Rge.) 12W Map No.

Operator Howard Alexander

Well No. 8 Farm Weber

Elev. 1886 Location SW NE SW

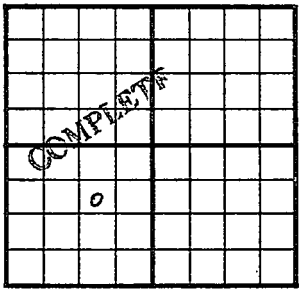

990 Ft. From N Line SW

990 Ft. From E Line Quarter

1st. Report

Completion DEC 1 2 1951

Remarks Kraft-Prusa Pool

Mouser Drlg. - Contr.

Spudding Date 8-21-51

Drlg. Data Oil well TD 3358

8" @ 400 Anhy 736 DST 2875-89

open 45 min. Rec. 70' ho & gcm

Lans. 3044 DST 3127-41 Rec. 30' mud &

sw DST 3216-26 open 1 hr. Rec. 120' oil

TD 3352 5" @ 3350 CO to 3352 water

PB 3265 Cong. 3310 29/ 3214-25

3000 A S/ 10 boph P/ 25 bopd

DD 3358 Gorham sand 3350 HFW

PB to KC Comp. 18 bopd 4% water

J. E. TYRA