

KANSAS


Butler

Section 21 Township 28 Range 8E

Well No. 19 Ferrel Ranch

Company Table & Mesa

Misc.
NORTH

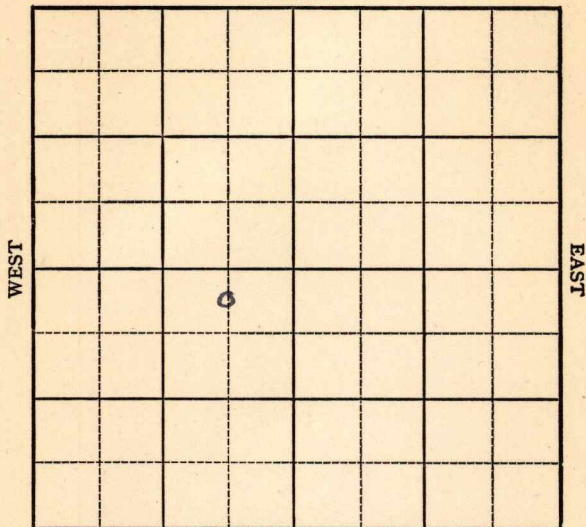

SOUTH

KANSAS

Butler

Sec. 21 Twp. 28 R. 8E

Well No. #19 Ferrel Ranch Farm

Table & Mesa

Company

Miscellaneous (Rex & Morris, Cont.) NORTH


330' Ft. from N. Line

 Ft. from S. Line

660' Ft. from E. Line

 Ft. from W. Line

C N L NE SW

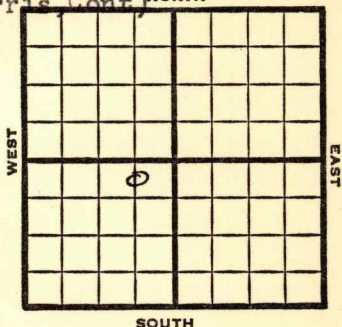

1949

Elev.

REPORT

8/3

Drlg. 260'

8/10

12" @ 930'

Drlg. 1245'

8/17

10" @ 1480'

Drlg. 1850'

8/24

8" @ 1980'

Drlg 2350'

8/31

Mississippi 2617-47'

TD 2647'

5" @ 2625'

9/7

Miss 2617'

5" @ 2625'

Acid 3000

Pump 35 oil Pot.

Grav. 38°

TD 2647'

COMPLETED

~~Kansas~~

Miscellaneous

Map No. _____ Sec. 21 Twp. 28 R. 8EWell No. 19 Ferrel Ranch

Table & Mesa

Company

Rex & Morris

Contractor

C N L NE SW

FIRST REPORT
SECTION PLAT330 Ft. from N. Line

_____ Ft. from S. Line

660 Ft. from E. Line

_____ Ft. from W. Line

	6		

Butler County

Location _____

Rig up _____

Drilling and Remarks:

260

RECORD

Cased _____ in., _____ ft.

Sand _____

Gas _____

Oil _____

Total Depth _____

PRODUCTION

1st 24 hrs. Nat. _____

1st 24 hrs. after shot _____

Gas _____ Cu. Ft.

Dry Hole _____

Abandoned _____

Date

AUG 3 1949 19S. J. LEWIS Scout

Kansas

Map No. X10 Sec. 21 Twp. 28 R. 8EWell No. 19 Ferrel Ranch

Table Mesa

Company

COMPLETE

Contractor

C N L NE SW

SECTION PLAT

	o		

330 Ft. from N. Line Ft. from S. Line660 Ft. from E. Line Ft. from W. Line

Butler County

RECORD

Location Rig up

Drilling and Remarks:

Cased in., ft.Sand Gas Oil Total Depth 2647

PRODUCTION

1st 24 hrs. Nat. 1st 24 hrs. after shot Gas Cu. Ft.Dry Hole Abandoned

Date

SEP 7 1949 19

S. J. LEWIS

Scout

Wells 261?
5' 02625
3500 and
Pump 3500 and
3500