


SECTION 10 TOWNSHIP 18 RANGE 1W

WELL NO. # 2 Dozier

COMPANY Osage Oil & Gas

2

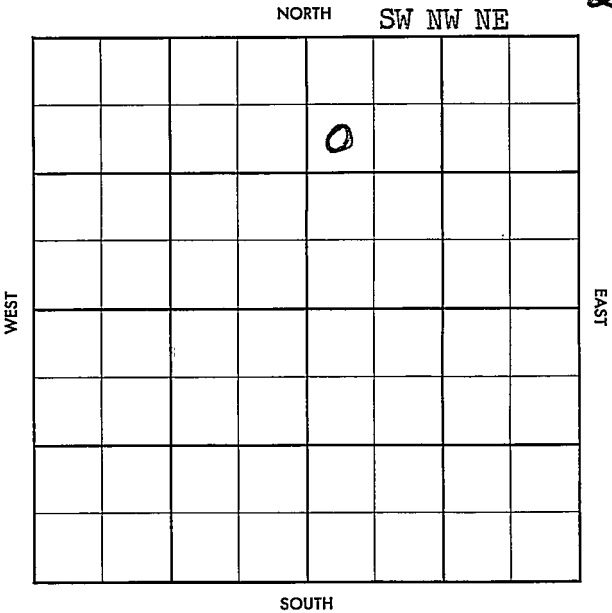

County McPherson Elev. 1404 DF  
 Sec. 10 Twp. 18 Rge. 1W  
 Company Osage Oil & Gas  
 Farm Name Dozier No. \_\_\_\_\_

TOPS	DEPTH	LOG	DATUM
Anh.			
Tr.			
H.			
Tr.			
Dg.			
Bl.			
L.			
K.C.			
B.K.C.			
Ce.			
C.			
M.			
M.			
K.			
Mz.			
Ma.			
V.			
S.			
S.			
A			
R.			
Pe.			
G.			
T.D.			

Loc. in Sec. SW NW NE  
 Geol. \_\_\_\_\_  
 Contr. Garvey Tools  
 Pool \_\_\_\_\_

FIRST REPORT		
JUN 26 '57		

Date Comm. 6-19-57  
8" @ 179/125, Drlg. 2454

~~7~~

Co. No. Sec. T. R.

County McPherson Elev. 1404 DF  
 Sec. 10 Twp. 18 Rge. 1W  
 Company Osage Oil & Gas  
 Farm Name Bozier No. 2

TOPS	DEPTH	LOG	DATUM
Anh.			
Ip.			
H.	<u>1905</u>		
Tr.			
Dg.			
Bl.	<u>2083</u>		
L.	<u>2132</u>		
K.C.			
B.K.C.			
Ce.			
C.			
M.	<u>2703</u>		
M.			
K.			
Mz.			
Me.			
V.	<u>3159</u>		
S.			
S.			
A.			
R.			
PE.			
G.			
T.D.	<u>3189</u>		

Loc. in Sec. SW NW NE  
 Geol. \_\_\_\_\_  
 Contr. \_\_\_\_\_  
Garvey Tools  
 Pool \_\_\_\_\_

	o	
	JUL 17 '57	
<b>COMPLETE</b>		

Date Comm. 6-19-57

8" @ 179/125, Drlg. 2454 " 3" DST  
2704-16 90" 20' VHOCM BHP  
125/30" DST 2716-33 1hr 30'  
oil + 60' VHOCM + 100' WE  
600/30 DST 2742-41 1hr 120'  
Gas + 70' VHOCM BHP 560  
DST 3151-56 1hr 15' VHOCM  
+ 50' OCM BHP 625/30" 5 1/2  
3189/125 " 3' 57 32/2717-25"

Co.  
Sec.  
No.  
Sec.  
T.  
R.

$\$ \frac{1}{2}$  BO +  $\frac{1}{2}$  BW \$ 17

BO no time \$ 7 BO in  
30" 10% wt \$  $11\frac{3}{4}$  Bopk

6 hrs 10% wt POP

P. 80 BO + 8 BW 16 hrs

P. 25 Bopd + 8 BW