


Section 10 Township 18 Range 1W

Well No. #3 Tector (Tector)

Company Phillips

3

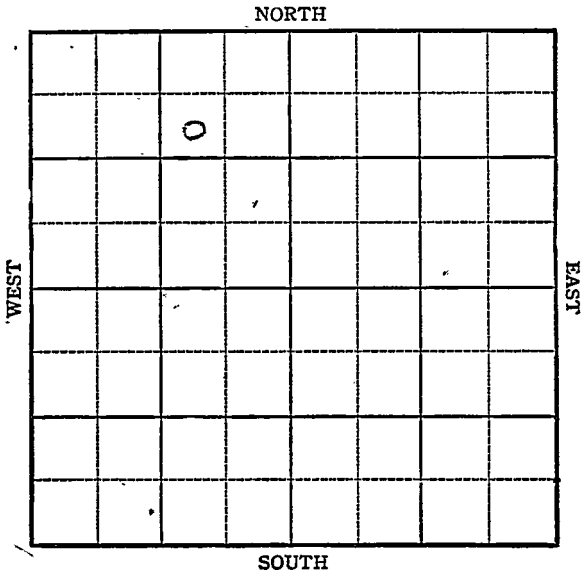

McPherson

KANSAS

Sec. 10 Twp. 18 R. 1W

Well No. #3 Tector Farm

Phillips Company


Baden

990 Ft. from N. Line

_____ Ft. from S. Line

990 Ft. from E. Line

_____ Ft. from W. Line

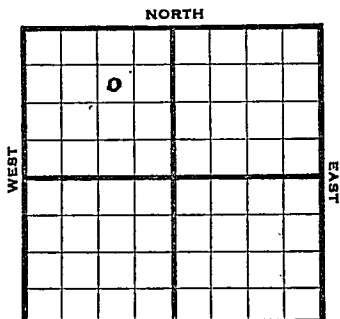

SW NE NW

Edwards 1272 SOUTH

1944

R E P O R T

- 9/20 Location
- 9/28 RUR
- 10/4 8" @ 212 Drlg. 1020
- 10/11 Miss 2693
Drlg. 2697 Sat.
- 10/18 Hunton 3021
Viola 3155-61TD
SSO & Gas
- 10/25 Simp 3239
Simp Sd 3258
Arb eelr
Drlg. 3580
- 11/1 Granite Wash 3870
Granite 3963
TD 3967
5" @ 3364 RUST
- 11/8 " " " " "
- 11/16 " " " " "
- 11/24 " " " " "
- 11/29 " " " " "
- 12/6 Granite 3963
5" @ 3364
TD 3967
Granite Wash 3870
SWD

ABANDONED

Pool Name Baden

~~KANSAS~~

Map No. 7 Sec. 10 Twp. 18 R. 1W

Well No. 3 Tector

Phillips Company

FIRST REPORT
SW NE NW Contractor

SECTION PLAT

990 Ft. from N. Line

_____ Ft. from S. Line

990 Ft. from E. Line

_____ Ft. from W. Line

	6		

McPherson County

Location X

Rig up _____

Drilling and Remarks:

RECORD

Cased _____ in., _____ ft.

Sand _____

Gas _____

Oil _____

Total Depth _____

PRODUCTION

1st 24 hrs. Nat. _____

1st 24 hrs. after shot _____

Gas _____ Cu. Ft.

Dry Hole _____

Abandoned _____

Date

SEP 20 1944 19 _____

S. J. LEWIS Scout

