


Section 25 Township 28 Range 8 E

Well No. # 1 Palmer

Company Rupp-Ferguson Oil

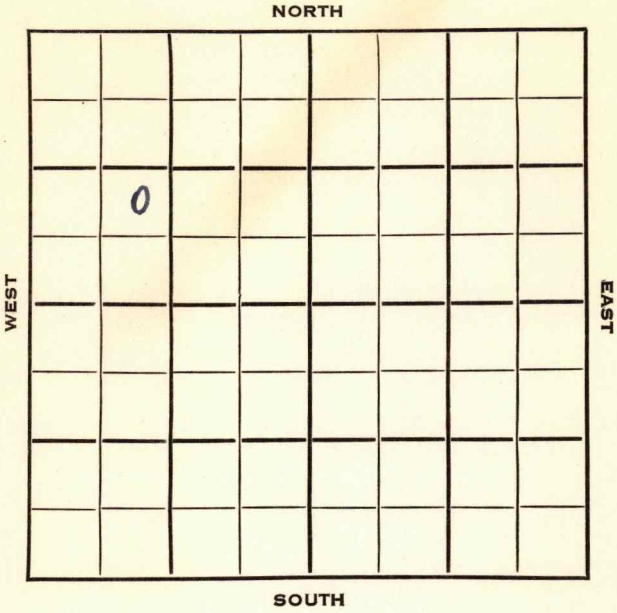

Elk

KANSAS


SEC.	TWP.	R.	✓
25	28	8 E	

WELL NO. # 1 Palmer FARM

COMPANY Rupp-Ferguson Oil

CONTRACTOR Musgrove

_____ Ft. from N. Line
 990 _____ Ft. from S. Line
 _____ Ft. from E. Line
 990 _____ Ft. from W. Line
 NE SW NW

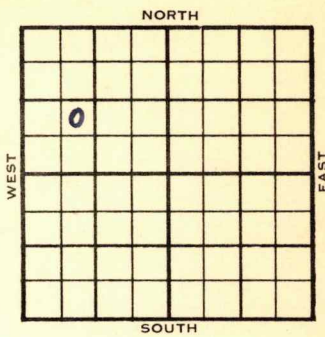

1953	ELEVATION	REPORT
	--	

10/21
 11/24

MIR
 Spid 10-20-53
 D&A
 TD 2985'
 8" @ 62'
 KC 1784', Cherokee 2326', Miss 2628',
 Kh. 2930', Arb. 2973'
 TD 2985'
~~M~~ D&A

ABANDONED

