

KANSAS

Butler



Sec. 28 Twp. 28 R. 8E

Well No. #18 Ferrell Ranch Farm

Table Mesa Company

Miscellaneous


330' Ft. from N. Line

_____ Ft. from S. Line

330' Ft. from E. Line

_____ Ft. from W. Line

NE NW

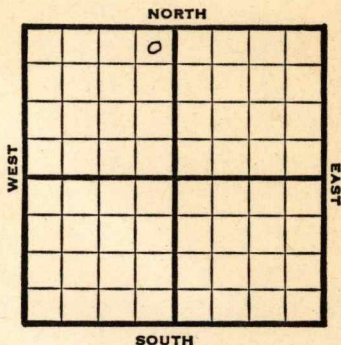

1948

Elev. -

REPORT

3/31 Machine

4/7 Drlg. 220'

4/14 18" @ 727'
Drlg. 995'

4/21 10" @ 1450'
Drlg. 1870'

4/28 8" @ 1950'
7" @ 2353'
Drlg. 2540'

5/5 Miss 2830'
TD 2880'

ABANDONED

Map No. _____ Sec. 28 Twp. 28 R. 8E

Well No. 18 Ferrell Ranch

Table Mesa _____ Company _____

FIRST REPORT _____ Contractor _____

NE NW

SECTION PLAT

330 _____ Ft. from N. Line

_____ Ft. from S. Line

330 _____ Ft. from E. Line

_____ Ft. from W. Line

Butler County

Location _____

Rig up _____

Drilling and Remarks:

Machine

RECORD

Cased _____ in., _____ ft.

Sand _____

Gas _____

Oil _____

Total Depth _____

PRODUCTION

1st 24 hrs. Nat. _____

1st 24 hrs. after shot _____

Gas _____ Cu. Ft.

Dry Hole _____

Abandoned _____

Date

MAR 31 1948 19 _____

S. J. LEWIS Scout

Map No. 10 Sec. 28 Twp. 28 R. 8E

Well No. 18 Ferrell Ranch

Table Mesa Company

ABANDONED Contractor

NE NW

SECTION PLAT

330 Ft. from N. Line

_____ Ft. from S. Line

330 Ft. from E. Line

_____ Ft. from W. Line

	8		

Butler County

Location _____

Rig up _____

Drilling and Remarks:

M 22830

RECORD

Cased _____ in., _____ ft.

Sand _____

Gas _____

Oil _____

Total Depth 2580

PRODUCTION

1st 24 hrs. Nat. _____

1st 24 hrs. after shot _____

Gas _____ Cu. Ft.

Dry Hole _____

Abandoned _____

Date

MAY 5 1948 19

S. J. LEWIS Scout