

SEC. 26	TWP. 26	R. 13E
------------	------------	-----------


WELL NO. #1 Kerns FARM

COMPANY Cecil Welch

CONTRACTOR #####

WILDCAT

_____ Ft. from N. Line
 _____ Ft. from S. Line
 _____ Ft. from E. Line
 _____ Ft. from W. Line

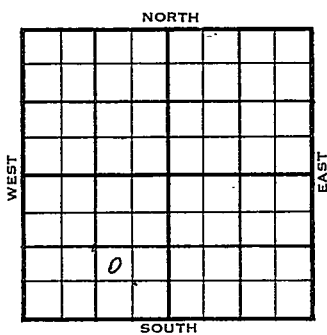

NW SE SW

Carter AC purch.

1956	ELEVATION 963 GF	REPORT
------	---------------------	--------

1-5 Comm. ~~12~~ 1-2-56
 Drlg.

4-11 DD 1515
 6 5/8" @ 1481
 PB 1487, 24/ 1474-80
 F/ 1 1/2 mcfg, 879 mcfg, 1/2 bfph, 46% wtr.
 1000 A
 F/ 8 bf, 30% oil 1 hr., SI 4 hrs.
 op 1 1/2 hrs., 1850 mcfgpd
 Comp. 3 mcfgpd, 1 boph, SI gas well
 L. # 325 331
 Peru 989 989
 Oswego 1096
 M. Dolo 1461 1461
 TD 1476

COMPLETED

County Woodson Elev. _____
 Sec. 26 26 Rge. 13E
 Company Cecil Welch
 Farm Name Kerns No. 1

TOPS	DEPTH	LOG	DATUM	Loc. in Sec.
Anh.				NW SE SW
Tp.				
H.				
Tr.				
Dg.				
Bl.				
L.				
K.C.				Geol. _____
B.K.C.				Contr. _____
Ce.				
C.				
M.				
M.				Pool _____
K.				<u>Wildcat</u>
Mz.				
Mo.				
V.				
S.				
S.				
A.				
R.				
Pe.				
G.				
T.D.				

FIRST REPORT
 JAN 5 '56
 0

Date Comm. 1-2-56 Carter AC purch
drie

[Large handwritten scribble]

Co.
Lse.
No.
Sec.
T.
R.

