
FORM 51 25M 8-50 WESTERN Woodson KANSAS

Section 26 Township 26 Range 13 E

Well No. # 1 M. K. Sample

Company Davis & Conkey

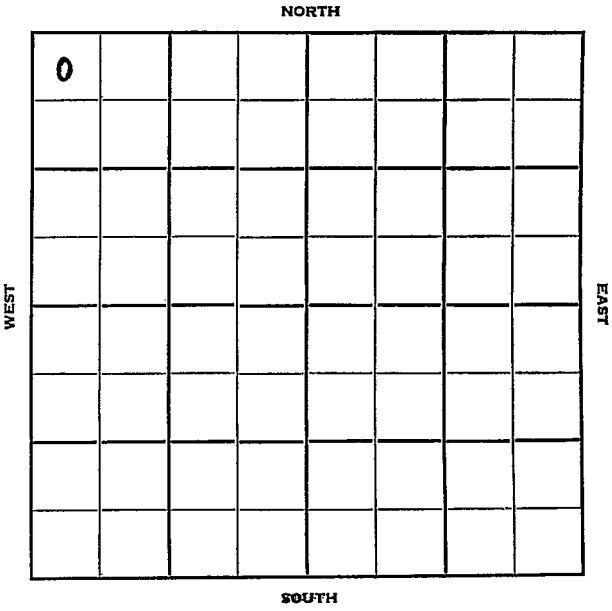

FORM 252-B
tOM 8-51 TPCO. Woodson KANSAS ✓

Sec. 26 Twp. 26 R. 13E

Well No. #1 M. K. Sample Farm

Davis & Conkey Company

Davis & Conkey - Contr. Contractor


330' Ft. from N. Line

Ft. from S. Line

Ft. from E. Line

990' Ft. from W. Line

NE NW NW

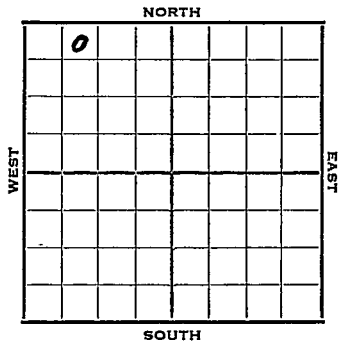

1952	Elev. - REPORT
9/4	Drlg. 850'
9/24	Bart 1420 TD 1530 D&A
	ABANDONED

FORM 275 FOR SALE BY KANSAS BLUE PRINT CO.


County Woodson State Kansas

Sec. 26 (Blk. Twp.) 26 (Sur. Rge.) 13E Map No.

Operator Davis & Conkey

Well No. 1 Farm M. K. Semple

Elev. Location NE NW NW

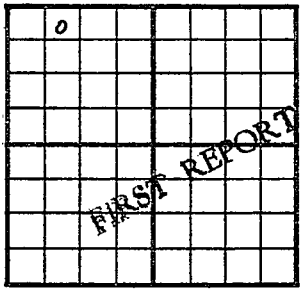

330 Ft. From N Line NW

990 Ft. From W Line Quarter

1st. Report SEP 4 1952

Completion

Remarks

Davis & Conkey - Contr.

Spudding Date

Drlg. Data

drlg- 850

J. G. McGEHEE

FORM 275 FOR SALE BY KANSAS BLUE PRINT CO.


County Woodson State ~~Kansas~~

Sec. 26 (Blk. Twp.) 26 (Sur. Rge.) 13E Map No.

Operator Davis & Conkey

Well No. 1 Farm M. K. Sample

Elev. Location NE NW NW

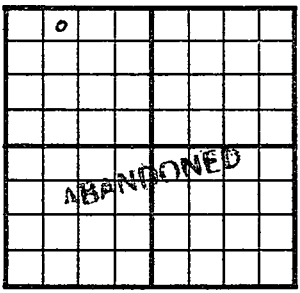

330 Ft. From N Line NW

990 Ft. From W Line Quarter

1st. Report

Completion SEP 24 1952

Remarks

Davis & Conkey - Contr.

Spudding Date

Drlg. Data

Bart. 1420 TD 1530 D & A

J. G. McGEHEE