

Woodson


KANSAS

SECTION 35 TOWNSHIP 26 RANGE 13 E

WELL NO. #1 McWherter

COMPANY M. R. Swearingin & Paul Carlson

NORTH

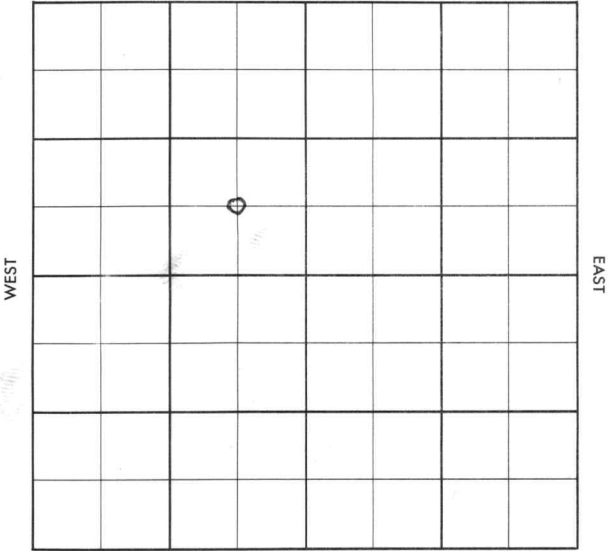

SOUTH

Woodson

KANSAS


| | | |
|------------|------------|-----------|
| SEC. 35 | TWP. 26 | R. 13E |
|------------|------------|-----------|

WELL NO. #1 McWherter FARM

COMPANY M.R. Swearingin & Paul Carlson

CONTRACTOR P. Carlson

1920 WILDCAT Ft. from N. Line
 Ft. from S. Line
 520 Ft. from E. Line
 Ft. from W. Line

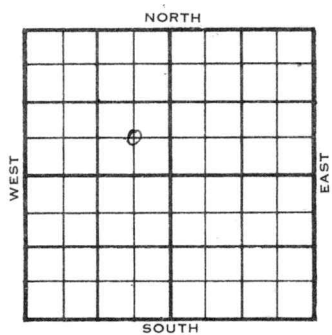

C SE NW

| 1955 | ELEVATION | REPORT |
|------|-----------|--------|
|------|-----------|--------|

12-14 4 1/2" @ 1422
 16/ 1417-20, A- frac
 100 A,
 Comp. 25 bopd, 35% wtr.
 Chat 1417
 TD 1422'

FIRST REPORT



COMPLETED

County **Woodson** Elev. _____
 Sec. **35** Twp. **26** Rge. **13E**
 Company **M. R. Swearingin & Paul Carlson**
 Farm Name **McWherter** No. **1**

| TOPS | DEPTH | LOG | DATUM | Loc. in Sec. |
|----------------|-------------|-----|-------|----------------|
| Anh. | | | | C SE NW |
| T.P. | | | | 1920' NL |
| H. | | | | 520' EL |
| Tr. | | | | |
| Dg. | | | | |
| B.L. | | | | |
| L. | | | | Geol. _____ |
| K.C. | | | | Contr. _____ |
| B.K.C. | | | | |
| Ce. | | | | P. Carlson |
| C. chat | 1417 | | | |
| M. | | | | Pool |
| M. | | | | Wildcat |
| K. | | | | |
| Mz. | | | | |
| Me. | | | | |
| V. | | | | |
| S. | | | | |
| S. | | | | |
| A. | | | | |
| R. | | | | |
| Pe. | | | | |
| G. | | | | |
| | | | | |
| | 1422 | | | |
| T.D. | | | | |

FIRST REPORT
 0
 DEC 14 '54
 COMPLETE

Date Comm. **4 1/2" @ 1422 16/ 1417-20 A-frac**
100 A Comp. 25 bopd 35% wtr.

Handwritten signature

Co.
Lse.
No.
Sec.
T.
R.